


Section 27 Township 19 Range 2W

Well No. #1-Anderson AKERSON

Company George Hess

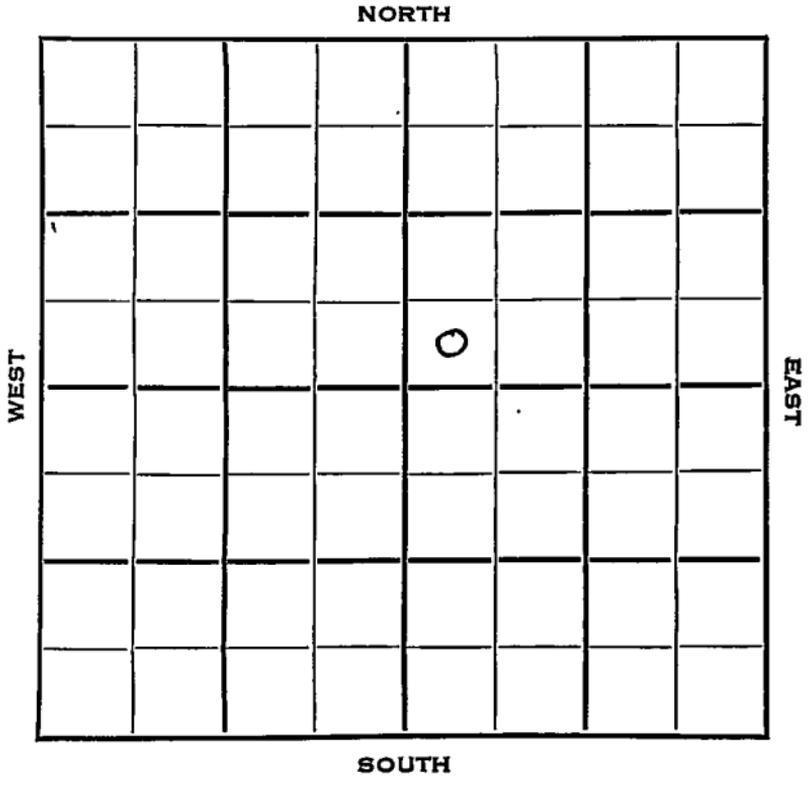

Sec. 27 Twp. 19 R. 2W

Well No. #1 ~~Anderson~~ ^{Akerson} Farm

George Hess Company

Mallard Drlg. Contractor

Lively Pool


 Ft. from N. Line

330 Ft. from S. Line

 Ft. from E. Line

330 Ft. from W. Line

SW SW NE

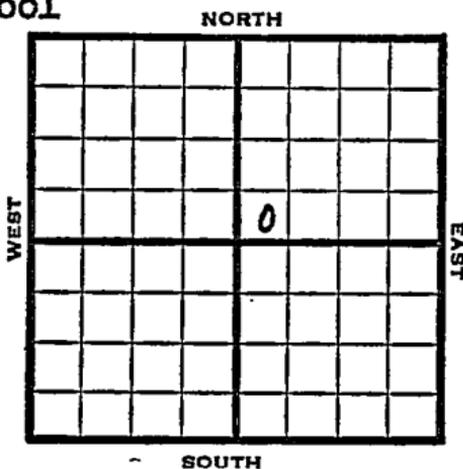

1953 Elev. 1547' REPORT

4/29 Spud 4-22-53
8-5/8" @ 147'
Drlg. 2200'

5/7 Lans 2320', Miss 2944
RTD 2948'
5" @ 2944' CO

5/21 DD 2952 FU 1900' fluid 24 hrs.
S/60 BOPD

5/28 P/ 40 boph / 15% w.

6/10 N.R.

7/8 "

7/22 P/18 bopd + 15% w

7/29 Spud 4-22-53 Oil well TD 2952
8-5/8" @ 147' Lans 2320 Miss 2944
TD 2948 5" @ 2944 DD 2952 FU 1900'
fluid 24 hrs. S/60 BOPD P/40 BOPD
15% wtr. P/30 BOPD 15% wtr.
P/18 BOPD 15% wtr.
Comp. 61 BOPD 10% wtr.

COMPLETED

KR0386

Map No. _____ Sec. 27 Twp. 19 R. 2W

Well No. 1 Akerson

Geo. Hess _____ Company

CORRECTION

Contractor

SW SW NE

SECTION PLAT

_____ Ft. from N. Line

330 Ft. from S. Line

_____ Ft. from E. Line

330 Ft. from W. Line

		o	

McPherson County

Location _____

Rig up _____

Drilling and Remarks:

Reported
#1 Anderson

RECORD

Cased _____ in., _____ ft.

Sand _____

Gas _____

Oil _____

Total Depth _____

PRODUCTION

1st 24 hrs. Nat. _____

1st 24 hrs. after shot _____

Gas _____ Cu. Ft.

Dry Hole _____

Abandoned _____

Date

MAY 6 1953

19

J. G. McGEHEE

Scout

