


Section 27 Township 19 Range 2W

Well No. 3 Anderson "B"

Company National Assoc.

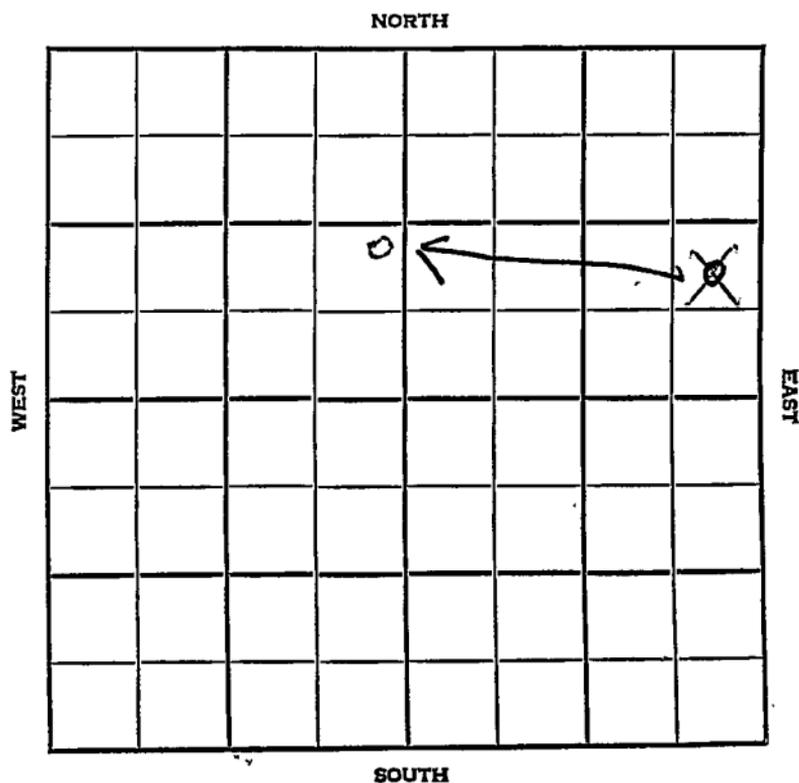

McPherson KANSAS


SEC.	TWP.	R.
27	19	2W

WELL NO. 3 Anderson "B" FARM

COMPANY National Assoc.

CONTRACTOR Lincoln Drlg.
Lively Pool

_____ Ft. from N. Line
 990 _____ Ft. from S. Line
 330 _____ Ft. from E. Line
 _____ Ft. from W. Line

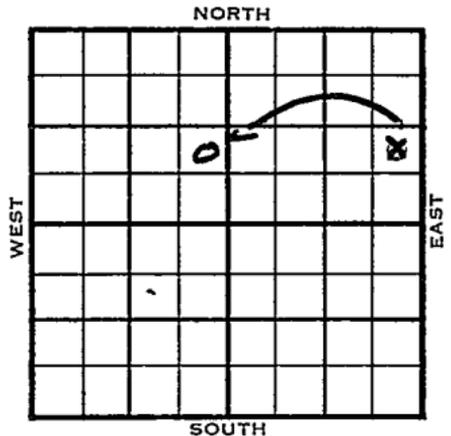

NE SE ^{NW} NE

1955 ELEVATION 1550' 1548' REPORT

2/23 MIR
~~4/6 Spud 1-24-55, oil well, TD 2966
 8" @ 154, KC 2318, Miss 2950,
 TD 2966, 5" @ 2959, CO to 2966
 S/1 1/2 BOPH 8 hr. frac S/6 B0 1
 BWPB 12 hr.
 Comp. 20 BOPD 35 BW~~

error

4/6 Spud 2-23-55, oil well, TD 2959, 8" @ 152, Lans 2324, DST 2325-43, open 1 hr, Rec 5' mud, 42#, Miss 2947 TD 2959, 5" @ 2950, CO to 2959 S/6 1/2 BOPH 16 hr. Comp. 40 BOPD 10 B W

COMPLETED

SCOUT TICKET

DX-201

Kansas

SEC.	TWP.	R.
27	19	2W

WELL NO.

3 Anderson "B"

FARM

COMPANY

National Assoc. Pet.

CONTRACTOR

CORRECTION

NE SE NW


NORTH

_____ FT. FROM N. LINE

990 FT. FROM S. LINE

330 FT. FORM E. LINE

_____ FT. FROM W. LINE

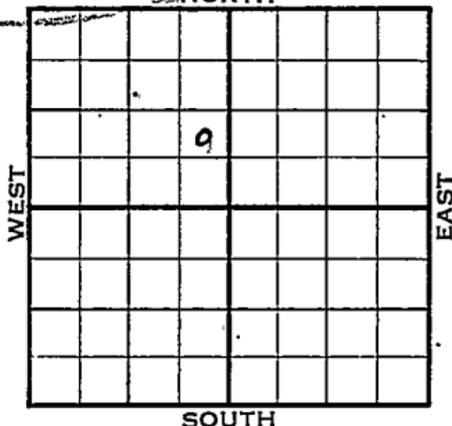

McPherson County

LOCATION

RIG UP

DRILLING AND REMARKS:

Reported
NE SE NE

RECORD

CASED IN., FT.

SAND

GAS

OIL

TOTAL DEPTH

PRODUCTION

1ST 24 HRS. NAT.

1ST 24 HRS. AFTER SHOT

GAS CU. FT.

DRY HOLE

ABANDONED

DATE

MAR

2 1955

SCOUT

FABEN GILSTRAP

