


Mc Pherson

Form 252-A
5M 4-32 MPC

Map No. KANSAS Sec. 27 Twp. 19 R. 2W

Well No. 1 McPherson Farm
Bush et al Company

_____ Ft. from N. Line
990 Ft. from S. Line
330 Ft. from E. Line
_____ Ft. from W. Line

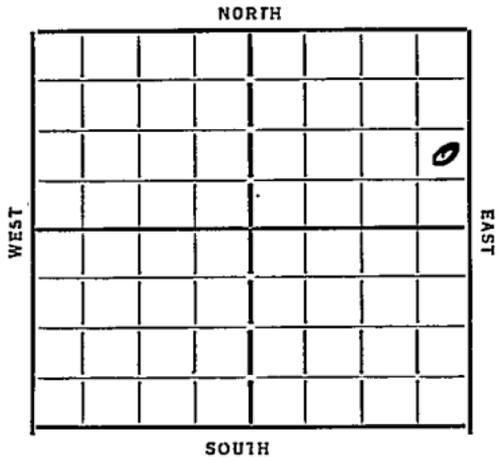

Date

REPORT

10/24 Material
11/1 _____
11/8 Rgn up
11/15 Dlg 215
11/22 " 615
11/28 _____
12/6 1325 run 10"
12/13 Dlg 1500
12/21 " 2209
12/27 _____ 1/3/35 _____
1/10 Dlg 2655 8" 2600
1/17 Lansing 2310 8" Collapsed at 2800
1/24 _____
1/31 Dlg 2805
2/7 W.C. 6" 2900
2/14 5" 2990
2/20 Chrt 2940 T 2990 10A

ABANDONED

Wepherson
Form 26—M Bks.—2-29

KANSAS

Map No. 43 Sec. 27 Twp. 19 R. 2 W

Well No. 1- Ekerson

Breslin et al Company

Contractor

FIRST REPORT

SECTION PLAT

_____ Ft. from N. Line

990 Ft. from S. Line

330 Ft. from E. Line

_____ Ft. from W. Line

			0

Location _____

Rig up _____

Drilling and Remarks:

Material

RECORD

Cased _____ in., _____ ft.

Sand _____

Gas _____

Oil _____

Total Depth _____

PRODUCTION

1st 24 hrs. Nat. _____

1st 24 hrs. after shot _____

Gas _____ Cu. Ft.

Dry Hole _____

Abandoned _____

Date

10-24-34₁₉

ORVAL MANNSCHEFER

Scout

Meperson

Map No. 43 Sec. 27 Twp. 19 R. 2 W

Well No. 1- Akerson

Breslin et al Company

Contractor

**ABANDONED
KANSAS**

SECTION PLAT

			0

..... Ft. from N. Line

990 Ft. from S. Line

330 Ft. from E. Line

..... Ft. from W. Line

Location.....

Rig up.....

Drilling and Remarks:

10 + 7

RECORD

Cased..... in., ft.

Sand Chat 2940

Gas.....

Oil.....

Total Depth 2990

PRODUCTION

1st 24 hrs. Nat.....

1st 24 hrs. after shot.....

Gas..... Cu. Ft.

Dry Hole.....

Abandoned.....

Date

2-20-35 192

ORVAL MANSCHRECK

Scout