


Section 27 Township 19 Range 2W


Well No. #1 Anderson

Company National Assoc. Petr.

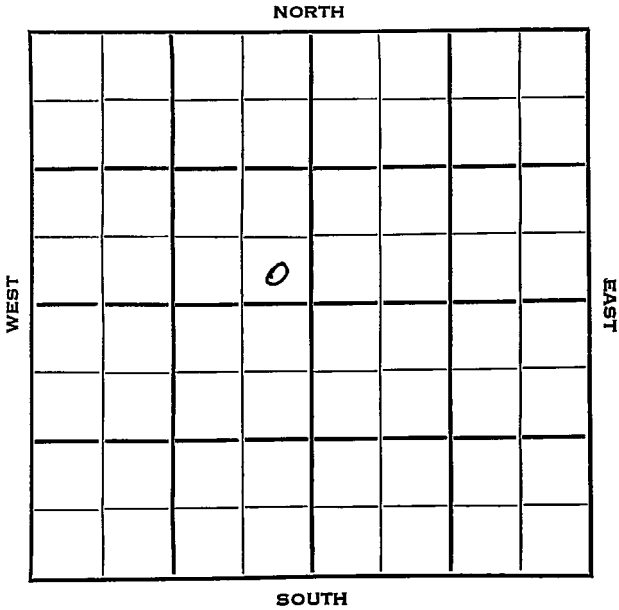

McPherson

KANSAS ✓

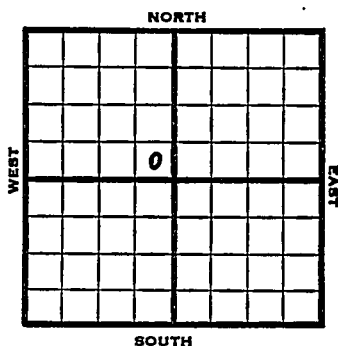Sec. 27 Twp. 19 R. 2 WWell No. # 1 Anderson FarmNational Assoc. Pet. CompanyNational Assoc. Contractor Ft. from N. Line330 Ft. from S. Line330 Ft. from E. Line Ft. from W. Line

SE SE NW

1953 Elev. 1546' REPORT

8/19 RUR

8/26 8" @ 165' Lans 2324' Miss 2948-56
RTD9/2 5" @ 2950'
CO 2956'
S/ 1 boph - 4 hrs. POP.

9/9 P/ 47 bopd.

9/23 Spud 8-17-53

Oil Well

TD 2956'

8" @ 165'

Lans. 2324, Miss 2948

TD 2956'

5" @ 2950'


CO to 2956

S/ 1 boph 4 hr. P/ 47 bopd P/ 27
bopd.

Comp. 23 bopd.

COMPLETED

County McPherson State Kansas
 Sec. 27 (Blk. Twp.) 19 (Sur. Rge.) 24 Map No.
 Operator National Assoc. Pet.
 Well No. 1 Farm Anderson
 Elev. _____ Location SE SE NW

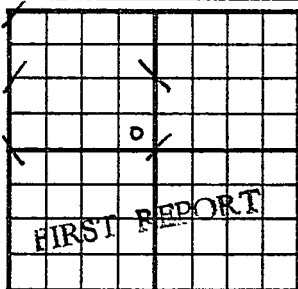


330 Ft. From S Line NW
330 Ft. From E Line Quarter
 1st. Report AUG 19 1953
 Completion _____
 Remarks _____
Nat'l Assoc. - Contr.
 Spudding Date _____

Drig. Data

R U R

J. G. McGEHEE

County Mcpherson State Kansas
 Sec. 27 (Blk.) 19 (Sur.) 2W Map No.
 Operator National Assoc. Pet.
 Well No. 1 Farm Anderson
 Elev. 1546 Location SE SE NW

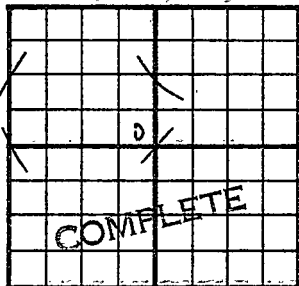

330 Ft. From S Line NW
330 Ft. From E Line Quarter

1st. Report
Completion SEP 23 1953

Remarks
Nat'l Assoc. - Contr.

Spudding Date 8-17-53

Drlg. Data Oil well TD 2956
8" @ 165 Lans. 2324 Miss. 2948
TD 2956 5" @ 2950 CO to 2956
S/ 1 boph 4 hr. P/ 47 bopd P/ 27 bopd
Comp. 23 bopd