


Section 27 Township 19 Range 2 W

Well No. # 1 Hill

Company Geo. Hess et al

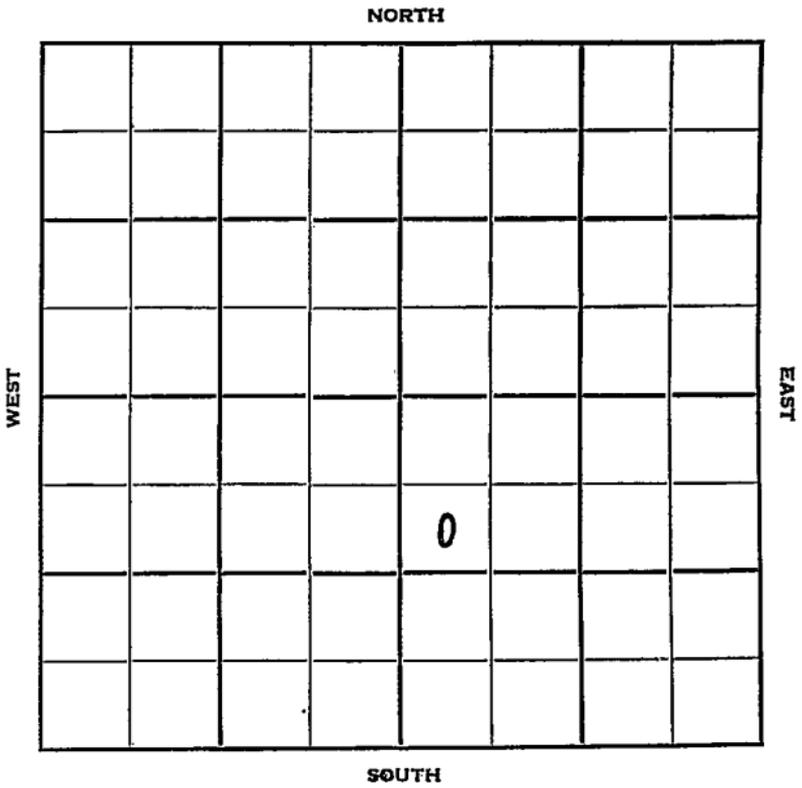

Sec. 27 Twp. 19 R. 2WWell No. #1 Hill FarmGeo. Hess et al Company

Contractor

Lively Pool


990 Ft. from N. Line

_____ Ft. from S. Line

_____ Ft. from E. Line

330 Ft. from W. Line

SW NW SE

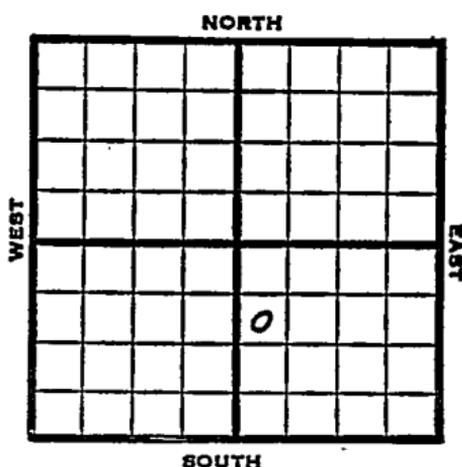

1953 Elev. 1551' REPORT

6/24 Spud 6-16-53
 8" @ 150'
 Miss 2956'
 TD 2958'
 5" @ 2957'

WOC

7/1 KC 2328
 DD 2960
 TD

FU 800' oil / 10% w.
 P/ 30 boph / some w/

7/29 Spud 6-16-53 Oil well TD 2960'
 8" @ 150 Miss 2956 TD 2958
 5 @ 2957 KC 2328 DD 2960
 FU 800' oil 10% wtr. P/30 BOPD
 P/40 BOPD
 Comp. 38 BOPD 7% wtr.

COMPLETED


County McPherson State Kansas

Sec. 27 (Blk. Twp.) 19 (Sur. Rge.) 2W Map No.

Operator Geo. Hess et al.

Well No. 7 Farm Hill

Elev. 1551 Location SW NW SE

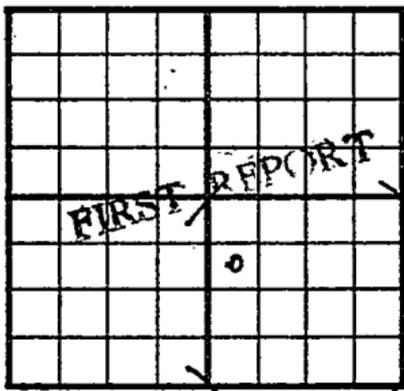

990 Ft. From SE Line SE

330 Ft. From W Line Quarter

1st. Report JUN 24 1953

Completion _____

Remarks _____

Spudding Date 6-16-53

Drlg. Data Lively Pool

8" @ 150 Miss. 2956 TD 2958

5" @ 2957 WOG

JUN 26 1958

Scout Cards	<i>[initials]</i>
Land Small Map	
Land Wall Map	<i>[initials]</i>
Tracings	
France Map	
Pierce Map	
Map	

Orig. Data


County McPherson State Kansas

Sec. 27 (Blk. Twp.) 19 (Sur. Rge.) 2W Map No.

Operator Geo. Hess et al.

Well No. 1 Farm Hill

Elev. 1551 Location SW NW SE

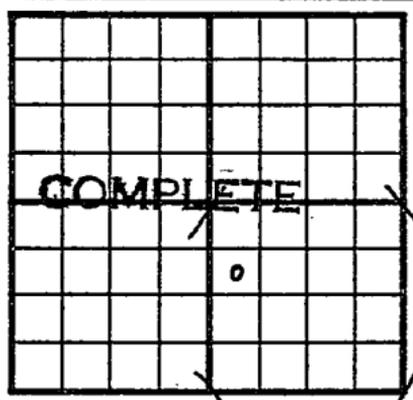

990 Ft. From N Line SE

330 Ft. From W Line Quarter

1st. Report

Completion JUL 29 1953

Remarks Lively Pool

Spudding Date 6-16-53

Drlg. Data Oil well TD 2960

8" @ 150 Miss. 2956 TD 2958

5" @ 2957 KC 2328 DD 2960 FU 800' oil

10% wtr. P/ 30 bopd P/ 40 bopd

Comp. 38 bopd 7% wtr.

1952

Scout Cards	<i>mm</i>
Land Small Map	
Land Wall Map	<i>3</i>
Tracings	
France Map	
Piece Map	
Misc.	

AUG 4 1952

Orig. Date