


Section 27 Township 19 Range 2 W

Well No. # 1 W. M. Rishel "A"

Company National Assoc. Pet.

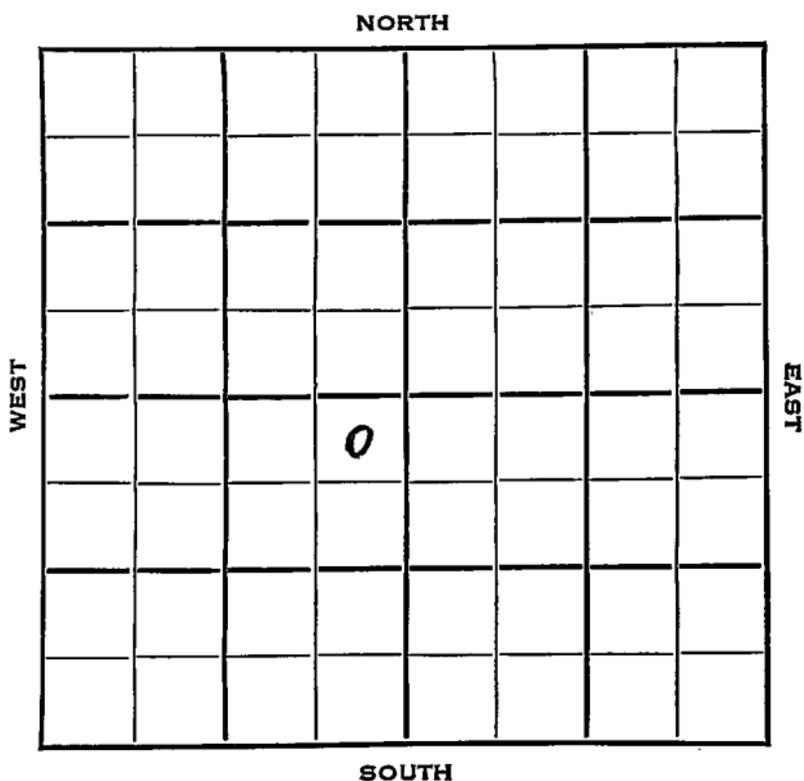

McPherson **KANSAS**

SEC. 27 TWP. 19 R. 2 W ✓

WELL NO. # 1 W. M. Rishel "A" FARM

COMPANY National Assoc. Pet.


CONTRACTOR Nat. Assoc. Pet.

Lively Pool
330 Ft. from N. Line

Ft. from S. Line

330 Ft. from E. Line

Ft. from W. Line

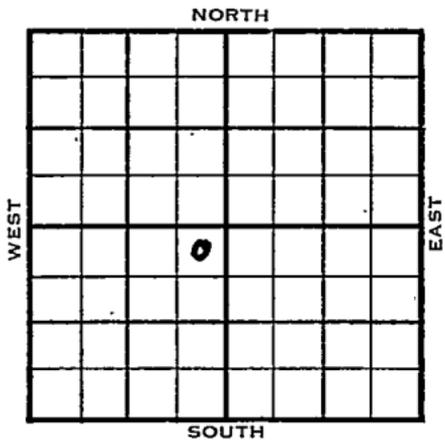

NE NE SW

1953 ELEVATION 1542' REPORT

10/14 MIR
 10/21 8" @ 164
 Drlg. 2605'
 10/28 RTD 2916'
 5" @ 2908'
 CO 2916'
 53 M-A
 FU 1800' oil 4 hrs.
 S/1½ boph
 11/4 NR
 11/11 "
 11/18 "
 11/24 Spud 10-13-53 Oil well TD 2950
 8" @ 164 Miss. 2941 TD 2950
 5" @ 2943 CO to 2950 53 mud-acid
 FU 1800' oil 4 hr. S/1½ BOPH
 Comp. 35 BOP^D

COMPLETED


County McPherson State Kansas

Sec. 27 (Blk. Twp.) 19 (Sur. Rge.) 2W Map No.

Operator National Assoc. Pet.

Well No. 1 Farm W. M. Rishel "A"

Elev. Location NE NE SW

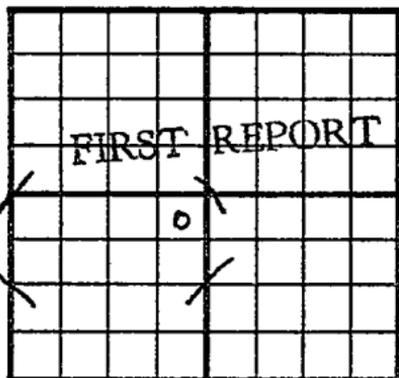

330 Ft. From N Line SW

330 Ft. From E Line Quarter

1st. Report OCT 14 1953

Completion

Remarks

Nat. Assoc. Pet. - Contr.

Spudding Date

Drlg. Data Lively Pool

N I R

