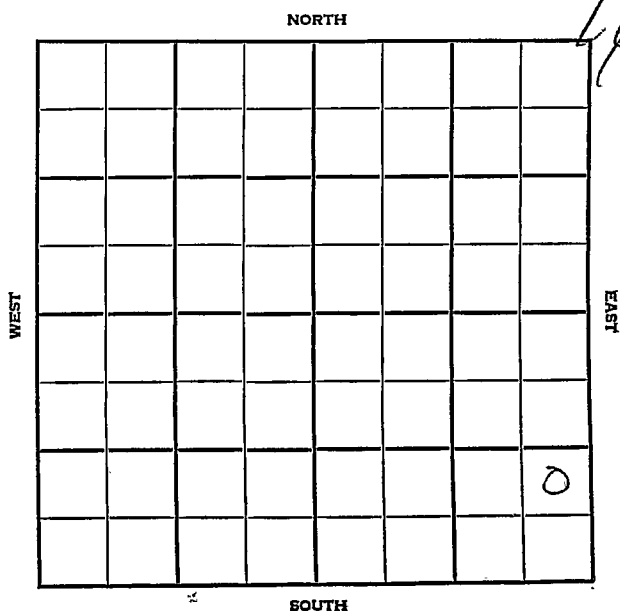


Section 27 Township 19 Range 13 WWell No. #1 MosesCompany Charles Hulme

Barton

KANSAS

SEC.	TWP.	R.
-27	19	13W

WELL NO.:

#1 Moses

FARM

COMPANY

Cahrles Hulme

CONTRACTOR

o Tools

Red Brisk


_____ Ft. from N. Line

_____ Ft. from S. Line

_____ Ft. from E. Line

_____ Ft. from W. Line

NE SE SE

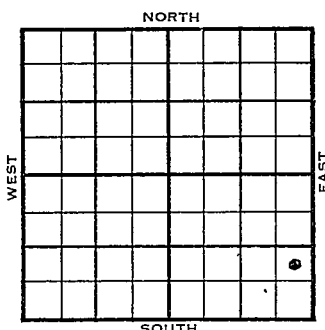

	ELEVATION	REPORT
1955	1842'	FIRST REPORT

8/10

8-7-55

8" @715/400 DRLG 1550

Anh: 704

9/28

Comm 8-7-55

8" @ 715/400

Anh

704

H

3044

B1

3147

L

3169

C

3404

A

3438

TD

3500

DST 3213-45 open 1 hr Rec 25' drlg

mud 575# DST 3355-97 open 1/2 hr.

Rec 30' mud 375/20" DST 3438-44

failed DST 3443-49 failed DST 3440-

49 open 1/2 hr Rec 85' mud 725/20"

DST 3449-62 open 1 hr gas in 10

min. Rec 1290' gassy oil 800/20"

5 1/2" @ 3499 CO 25/3450-55

500 A S/87 BO 4 hr Comp P & F

85 bopd 6% wtr.

COMPI ETED

County Barton Elev. _____
 Sec. 27- Twp. 12 Rge. 13W
 Company Charles Hulme
 Farm Name Moses No. 1

TOPS	DEPTH	LOG	DATUM	Loc. in Sec.
Anh.	<u>704</u>			<u>NE SE SE</u>
Tp.				
H.				
Tr.				
Dg.				
Bl.				
L.				
K.C.				Geol. _____
B.K.C.				Contr. _____
Ce.				<u>Co. tools</u>
C.				
M.				Pool _____
M.				<u>Red Brick</u>
K.				
Mz.				
Ma.				
V.				
S.				
S.				
A.				
R.				
Pf.				
G.				
T.D.				

AUG 10 '55

FIRST REPORT

Date Comm. 8-7-55
8" @ 715/400 drlg. 1550

[Handwritten signature]

County Barton Elev. 1842
 Sec. 27- Twp. 19 Rge. 13W
 Company Charles Holme
 Farm Name Moses No. 1

TOPS	DEPTH	LOG	DATUM	Loc. in Sec.
Anh.	704			NE SE SE
Tr.				
H.	3044		1202	
Tr.				
Dg.				
BL.	3147		1305	
L.	3169		1327	Geol.
K.C.				Contr.
B.K.C.				
Ce.				
C.	3404		1562	Co. tools
M.				
M.				Podl
K.				
Mz.				Red Brick
Me.				
V.				
S.				
S.				
A.	3438		1596	COMPLETE
R.				
Pe.				
G.				
T.D.	3500			

Date Comm. 8-7-55 SEP 28 1955
 8" @ 715/400 DST 3213-45 open 1 hr.
 Rec. 25' drlg. mud 575# DST 3355-97
 open $\frac{1}{2}$ hr. Rec. 30' mud 375/20"
 DST 3438-44 failed DST 3443-49 failed
 DST 3440-49 open $\frac{1}{2}$ hr. Rec. 85' mud
 725/20" DST 3449-62 open 1 hr.
 gas in 10 min. Rec. 1290' gassy oil
 800/20" 5 $\frac{1}{2}$ " @ 3499 CO 25/ 3450-55

OVER

500A S/ 87 bo 4 hr.

Comp. P & F/ 85 bopd. 6% wtr.

_____	Misc.
_____	Pierce Map
_____	France Map
_____	Tracings
_____	Land Wall Map
_____	Land Small Map
_____	Scout Cards

W. W. W.

OCT 6 1955