


Section 27 Township 19 Range 13W

Well No. 1 Suchy

Company Hilton Drlg. *4*

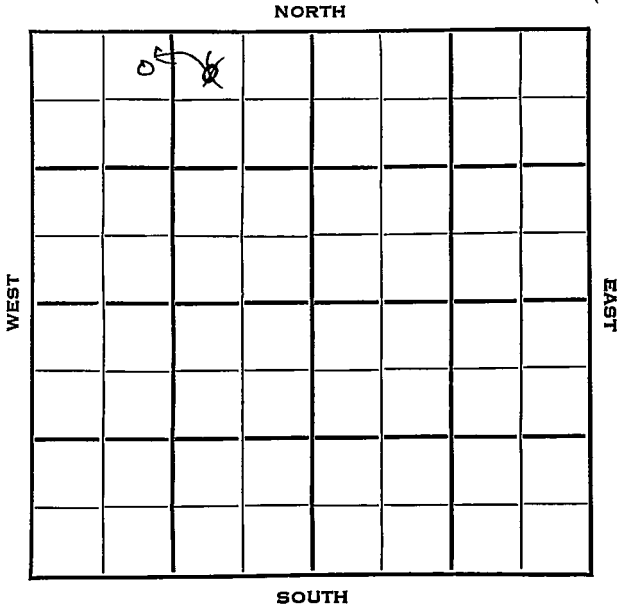

Barton KANSAS


SEC. 27 TWP. 19 R. 13W ✓

WELL NO. I Suchy FARM

COMPANY Hilton Drlg.

CONTRACTOR Hilton Drlg.

330 _____ Ft. from N. Line
 _____ Ft. from S. Line
~~990~~ _____ Ft. from E. Line
 990 _____ Ft. from W. Line

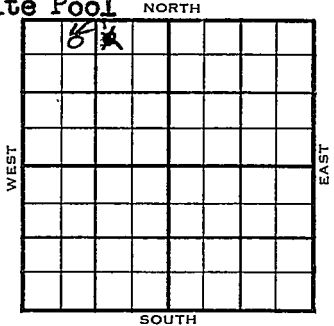

NE NW NW
 NW NE NW

	ELEVATION	REPORT
1954	1846'	
1/6	MIR	
1/13	8" @ 738' w/400 Anhy 729'	
1/27	Drlg. 2900' NR	
2/17	Spud 1-6-54 Oil Well TD 3428' 8" @ 738' Anhy 729', Heeb 3044', Br lime 3142', Lans 3154' DST 3213-30, opn 9 mins., gas in 6 mins. F/oil in 8 mins., 1245# Cong 3378', Arb. 3409' TD 3428' 5" @ 3426' CO to 3428' 1/2 goph PB 3424, 24/3417-23, 7 goph 500A frac, SP 3260, 35/3222-28, F/oil 1250A, F 40 boph 6 hrs. Comp. 3000 bopd	

COMPLETED

Map No. _____ Sec. 27 Twp. 19 R. 13W

Well No. 1 Suchy

Hilton Drlg. Company

CORRECTION Contractor

NE NW NW

SECTION PLAT

330 Ft. from N. Line

_____ Ft. from S. Line

_____ Ft. from E. Line

990 Ft. from W. Line

6			

Barton County

Location _____

Rig up _____

Drilling and Remarks:

Reported

NW NE NW

RECORD

Cased _____ in., _____ ft.

Sand _____

Gas _____

Oil _____

Total Depth _____

PRODUCTION

1st 24 hrs. Nat. _____

1st 24 hrs. after shot _____

Gas _____ Cu. Ft.

Dry Hole _____

Abandoned _____

Date

JAN 13 1954 19

J. G. McGEHÉE

Scout

