

DX 78-1


Rush

KANSAS

Section 27 Township 19 Range 19W

Well No. #1 Pfenninger

Company Parker Pet.

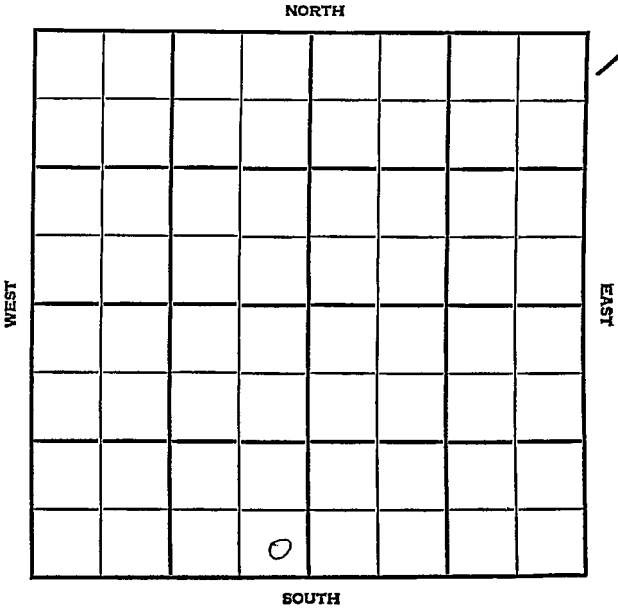

County Rush Elev. _____
 Sec. 27 Twp. 19 Rge. 12
 Company Father Pet.
 Farm Name Kenninger No. 1

TOPS	DEPTH	LOG	DATUM
Arb.			
Tr.			
H.	3704		
Tr.			
Dg.			
Bl.			
L.	3753		
K.C.			
B.K.C.	4088		
Ce.			
C. <u>Cherty</u>	4182		
M.			
M.			
K.			
Mz.			
Mo.			
V.			
S.			
S.			
A.	4208		
R.			
PE.			
G.			
TD.	4265		

Loc. in Sec. _____
 Arb. test
 Geol. _____
 Contr. _____
 Serobec
 Pool _____
 Wildcat

ABANDONED
 JUL 11 1956

Date Comm. 6-20-56 CSC - 70

8" @ 251/150 dnlr. 2501 JUL: 3900

JUL 11 '56 DST 4182-4206 1hr rec

300' MSW BHP 1035/20"

D E A

Co.

Use.

No.

Sec.

T.

R.