


Section 27 Township 19 Range 16 W

Well No. 2 Dinks (Dinks)

Company Magnolia

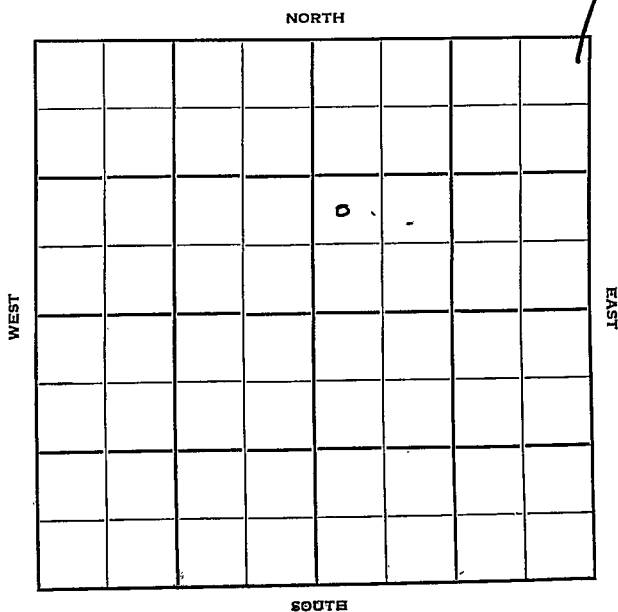

KANSAS

Rush

Sec. 27 Twp. 19 R. 16W ✓

Well No. #2 Dirks Farm

Magnolia Company

Contractor


Ft. from N. Line

990 Ft. from S. Line

Ft. from E. Line

330 Ft. from W. Line

NW SW NE

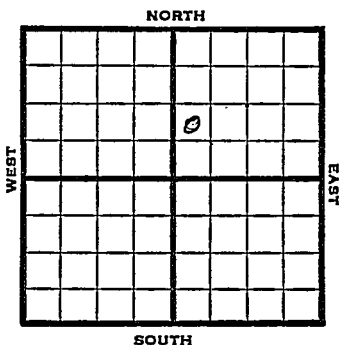

1950

Elev. 2041'

REPORT

5/10

Spud 5-6-50

Dr1g. 915

6/7

KC 3434'

-Arb 3731'

5" -@ 3772'

Pump & flow 27 BO 18 hrs

& 500,000 CFGPD

TD 3789'

COMPLETED

Map No. _____ Sec. 27 Twp. 19 R. 16WWell No. 2 Dinks_____ Magnolia _____ Company

_____ Contractor

NW SW NE

SECTION PLAT

_____ Ft. from N. Line

990 Ft. from S. Line

_____ Ft. from E. Line

330 Ft. from W. Line

		o	
FIRST REPORT			

Rush

Location _____

Rig up _____

Drilling and Remarks:

Spud 5-6-50

Drlg. 915

RECORD

Cased _____ in., _____ ft.

Sand _____

Gas _____

Oil _____

Total Depth _____

PRODUCTION

1st 24 hrs. Nat. _____

1st 24 hrs. after shot _____

Gas _____ Cu. Ft.

Dry Hole _____

Abandoned _____

Date

MAY 10 1950.19J. E. TYRA

Scout

Kansas

Map No. _____ Sec. 27 _____ Twp. 19 _____ R. 16W _____

Well No. 2 Dirks _____


Magnolia _____ Company _____

_____ Contractor _____

N^W SW NE

El. 2041

SECTION FLAT

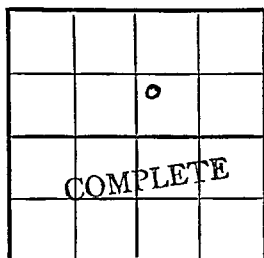

_____ Ft. from N. Line

990 _____ Ft. from S. Line

_____ Ft. from E. Line

330 _____ Ft. from W. Line

Rush

Location _____

Rig up _____

Drilling and Remarks:

K.C. 3434
 Arb 3731
 5" @ 3772
 Pump & Flow
 27 B.O. 18 Hrs.
 + 500,000 CF6 PD

RECORD

Cased _____ in., _____ ft.

Sand _____

Gas _____

Oil _____

Total Depth 3789 _____

PRODUCTION

1st 24 hrs. Nat. _____

1st 24 hrs. after shot _____

Gas _____ Cu. Ft.

Dry Hole _____

Abandoned _____

Date

JUN 7 1950 19

J. E. TVRA Scout