


Section 27 Township 19 Range 16W

Well No. #2 Dirks

Company Texas

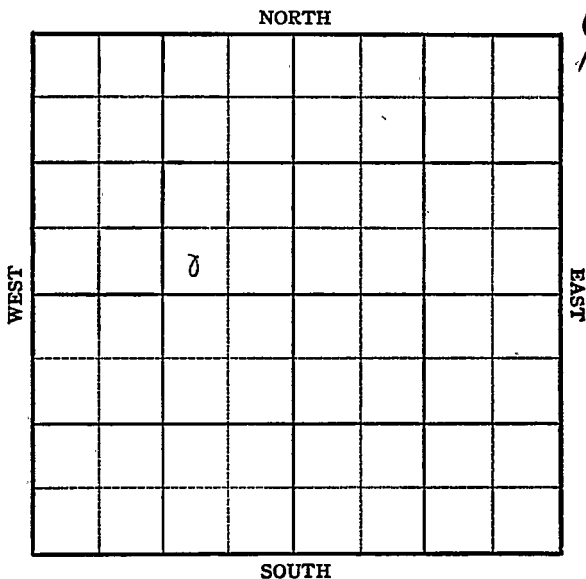

Sec. 27 Twp. 19 R. 16W

Well No. #2 Dirks Farm

Texas

Ryan Pool Company

\_\_\_\_\_ Ft. from N. Line

330'


\_\_\_\_\_ Ft. from S. Line

990'

\_\_\_\_\_ Ft. from E. Line

\_\_\_\_\_ Ft. from W. Line

SW SE NW

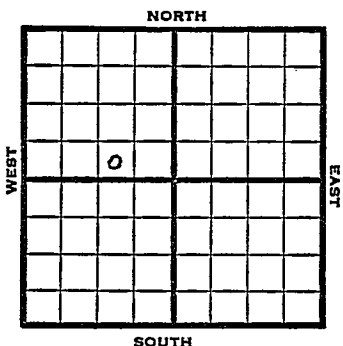

1949 Elev 2064' REPORT

11/23 8" @ 1111'

11/29 Drlg 3324'

12/7 Lansing 3458'

Arb. 3738'

TD 3802

5" @ 3796'

12/14 "

12/21 "

12/28 "

1950

4/12 TD 3803'

8" @ 1111'

Lans 3458'

Arb. 3738'

5" @ 3796'

Flow 248 BO 14 hrs.

Comp

**COMPLETED**

Map No. \_\_\_\_\_ Sec. 27 Twp. 19 R. 16W

Well No. 2 Dirks

\_\_\_\_\_ Texas \_\_\_\_\_ Company

\_\_\_\_\_ Contractor

SW SE NW

FIRST REPORT  
SECTION PLAT

\_\_\_\_\_ Ft. from N. Line

330 Ft. from S. Line

990 Ft. from E. Line

\_\_\_\_\_ Ft. from W. Line

	e		

Rush County

Location \_\_\_\_\_

Rig up \_\_\_\_\_

Drilling and Remarks:

8" @ 1111

RECORD

Cased \_\_\_\_\_ in., \_\_\_\_\_ ft.

Sand \_\_\_\_\_

Gas \_\_\_\_\_

Oil \_\_\_\_\_

Total Depth \_\_\_\_\_

PRODUCTION

1st 24 hrs. Nat. \_\_\_\_\_

1st 24 hrs. after shot \_\_\_\_\_

Gas \_\_\_\_\_ Cu. Ft.

Dry Hole \_\_\_\_\_

Abandoned \_\_\_\_\_

Date

NOV 23 1949 19

S. J. LEWIS

Scout

Map No. \_\_\_\_\_ Sec. 27 Twp. 19 R. 16WWell No. 2 Dirks

Texas

Company \_\_\_\_\_

Contractor \_\_\_\_\_

SW SE NW

*El. 2064*  
SECTION PLAT

\_\_\_\_\_ Ft. from N. Line

330 Ft. from S. Line990 Ft. from E. Line

\_\_\_\_\_ Ft. from W. Line

	<b>COMPLETE</b>		
	o		

Rush County

Location \_\_\_\_\_

Rig up \_\_\_\_\_

Drilling and Remarks:

*8" @ 1111  
Lans 23458  
arb 3738  
5" @ 3796  
Flow 24880  
14 hrs.*

## RECORD

Cased \_\_\_\_\_ in., \_\_\_\_\_ ft.

Sand \_\_\_\_\_

Gas \_\_\_\_\_

Oil \_\_\_\_\_

Total Depth 3803

## PRODUCTION

1st 24 hrs. Nat. \_\_\_\_\_

1st 24 hrs. after shot \_\_\_\_\_

Gas \_\_\_\_\_ Cu. Ft.

Dry Hole \_\_\_\_\_

Abandoned \_\_\_\_\_

Date

APR 12 195019J. E. TYRAScout