

Section 27 Township 19 Range 16-W

Well No. #5 Dirks

Company Texas

3

NORTH

WEST

EAST

		0					

SOUTH

Rush

KANSAS

Sec. 27 Twp. 19 R. 16W ✓

Well No. #5 Dirks Farm

Texas Company

Contractor


Ryan
990' Ft. from N. Line

_____ Ft. from S. Line

990' Ft. from E. Line

_____ Ft. from W. Line

SW NE NW

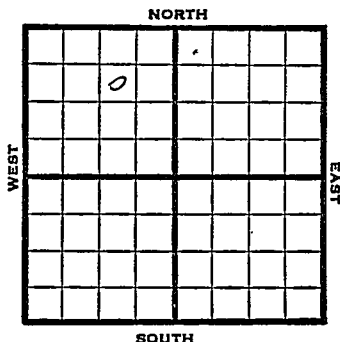

1950 Elev 2063 REPORT

5/31 Location

7/19 10" @ 1108

Heeb 3380

Lans 3464

7" @ 3895

S/7 bo 12 hr

500 acid

S/12 $\frac{1}{2}$ bo 13 hr

TD 3809

1000 acid

S/1 boph 5 hr

21/3788-90

1000 acid

Comp 35 bopd

Completed

COMPLETED

Br lime 3452
Arb 3739-3802

Map No. _____ Sec. 27 Twp. 19 R. 16WWell No. 5 Dirks

Texas _____ Company _____

_____ Contractor _____

SW NF NW

SECTION PLAT

990 Ft. from N. Line

_____ Ft. from S. Line

990 Ft. from E. Line

_____ Ft. from W. Line

	a		
FIRST		REPORT	

Rush

Location X

Rig up _____

Drilling and Remarks: _____

RECORD

Cased _____ in., _____ ft.

Sand _____

Gas _____

Oil _____

Total Depth _____

PRODUCTION

1st 24 hrs. Nat. _____

1st 24 hrs. after shot _____

Gas _____ Cu. Ft.

Dry Hole _____

Abandoned _____

Date


MAY 31 1950₁₉J E TYPA Scout

Kansas

Ryan Pool

Map No. _____ Sec. 27 Twp. 19 R. 16WWell No. 5 DirksTexas_____
Company_____
Contractor

SW NE NW

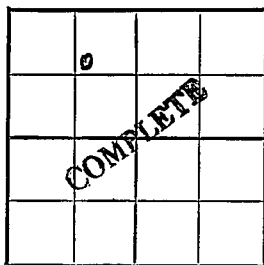E1. 2063
SECTION PLAT990 Ft. from N. Line_____
Ft. from S. Line990 Ft. from E. Line_____
Ft. from W. LineRush County

Location _____

Rig up _____

Drilling and Remarks:

10" @ 1108

Heeb. 3380

Br. lime 3452

Lans. 3464

Arb. 3739-3802

7" @ 3795

RECORD

Cased _____ in., _____ ft.

Sand _____

Gas _____

Oil _____

Total Depth 3809**PRODUCTION**

1st 24 hrs: Nat. _____

1st 24 hrs. after shot _____

Gas _____ Cu. Ft.

Dry Hole _____

Abandoned _____

Date

JUL 19 1950

19

J. E. TYRA

Scout

S/7 bo 12 hr.

500. acid

S/ $12\frac{1}{2}$ bo 13 hr.

TD 3809

2900 acid-

S/ 1-boph, 5 hr.

21/ 3786-90

1000 acid

Comp 35³bopd

Scout Cards
Land Small Map
Land Wall Map
Tracings
France Map
Pierce Map
Misc.

1950
AUG 1 1950
pd