

Rush


Section 27 Township 19 Range 16-W

Well No. #4 Rankin

Company Ben Brack

10

NORTH

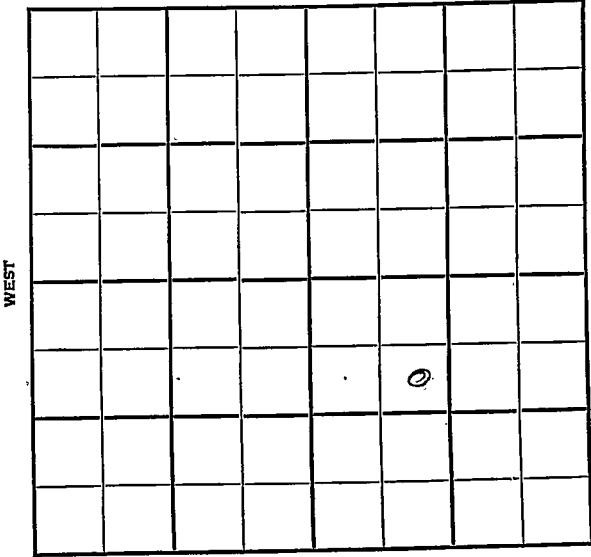

SOUTH

Sec. 27 Twp. 19 R. 16W ✓

Well No. #4 Rankin Farm  
Ben Brack Company

Ryan Pool


990' Ft. from N. Line

\_\_\_\_\_ Ft. from S. Line

\_\_\_\_\_ Ft. from E. Line

990' Ft. from W. Line

SE NW SE

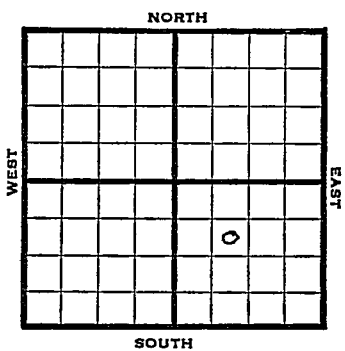

1948

Elev. 2026' REPORT

- 7/8 8" @ 791'  
Anhy. 1070'  
Drlg. 1330'
- 7/14 Drlg 3225'
- 7/21 Arbuckle 3712-62'  
TD 37-62'
- 7/28 5" @ 3761'  
2 1/2 M Gas
- 8/4 "
- 8/11 "
- 8/18 300 acid
- 8/25 1000 acid swb 5 bbls a day (oil)
- 9/1 20 shots 3057-61 - 300 acid swb  
25 bbls oil & W 16 hrs.
- 9/8 Arb 3712'  
5" @ 3761'  
TD 3762'.  
Perf.  
1600 acid  
Pump 85 oil Pot.  
Gr. 39°

COMPLETED

Map No. \_\_\_\_\_ Sec. 27 Twp. 19 R. 16W

Well No. 4 Rankin

Ben Brack Company

FIRST REPORT Contractor

SE NW SE

SECTION PLAT

990 Ft. from N. Line

\_\_\_\_\_ Ft. from S. Line

\_\_\_\_\_ Ft. from E. Line

990 Ft. from W. Line


Rush County

RECORD

Location \_\_\_\_\_

Rig up \_\_\_\_\_

Drilling and Remarks:

8" @ 791

Anhy 1070

drlg. 1330

Cased \_\_\_\_\_ in., \_\_\_\_\_ ft.

Sand \_\_\_\_\_

Gas \_\_\_\_\_

Oil \_\_\_\_\_

Total Depth \_\_\_\_\_

PRODUCTION

1st 24 hrs. Nat. \_\_\_\_\_

1st 24 hrs. after shot \_\_\_\_\_

Gas \_\_\_\_\_ Cu. Ft.

Dry Hole \_\_\_\_\_

Abandoned \_\_\_\_\_

Date

JUL 8 1948 19

S. J. LEWIS

Scout

Rush County Kansas State  
87 Map No. Sec. 27 Twp. 19 R. 16W

Well No. 4 Rankin  
Ben Brack Company

COMPLETE Contractor

SE NW SE

E12026  
SECTION PLAT


990 Ft. from N. Line  
\_\_\_\_\_ Ft. from S. Line  
\_\_\_\_\_ Ft. from E. Line  
990 Ft. from W. Line

Ryan Pool

Remarks:


Date SEP 8 1948

Scout S. J. LEWIS