

Section 27 Township 19 Range 16 WWell No. # 6 W. H. DirksCompany Texas Company

NORTH

	0						

WEST

EAST

SOUTH

Sec. 27 Twp. 19 R. 16WWell No. #6 W. H. Dirks FarmTexas Co. Company

Contractor


Ft. from N. Line

330' Ft. from S. Line

Ft. from E. Line


990' Ft. from W. Line

SE SW NW

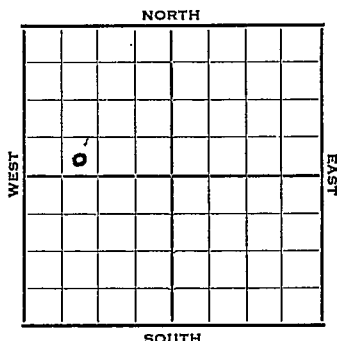

1952	Elev. 2083	REPORT
6/11	Location	
6/18	8" @ 1125 Drlg. 1190'	
6/25	Drlg. 3110'	
7/2	Heeb. 3403 Br Li 3474 Lans. 3489 DST 3496-3510 1 hr. 950' SW 1200# 15" Marm 3708 Arb. 3763 Coring 3772-3825 TD Schl	
7/9	5" @ 3822' on Pump	
7/17	BACK DOPE: CO 3825' S/1½ BOPH & trace 500 A S/7 BOPH 6% wtr. POP	
7/23	Spud 6-14-52 Oil Well TD 3825 8" @ 1125 Heeb. 3402 Br Lime 3474 Lans. 3489 DST 3496-3510 opn 1 hr. Rec. 950' sw 1200# Marm 3708 Arb. 3763 TD 3825 5" @ 3822 CO to 3825 S/1½ boph 500 A S/7 boph 6% wtr Comp. 72 bopd	

County Rush State KANSAS
 Sec. 27 (Blk. Twp.) 19 (Sur. Rge.) 16W Map No.
 Operator Texas Company
 Well No. 6 Farm W. H. Dirks
 Elev. _____ Location SE SW NW

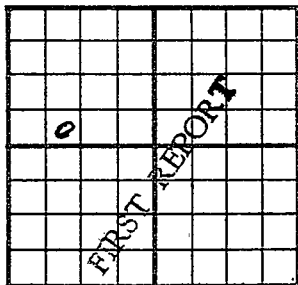


330 Ft. From S Line NW
990 Ft. From W Line Quarter
 Ist. Report JUN 11 1952
 Completion _____
 Remarks _____
 Spudding Date _____

Drlg. Data _____

Location

J. G. McGEHEE

County Rush State Kansas
 Sec. 27 (Blk. 19 (Sur. 16 Map No.
 (Twp.) (Rge.)
 Operator Texas Company
 Well No. 6 Farm W. H. Dirks
 Elev. 2083 Location SE SW NW

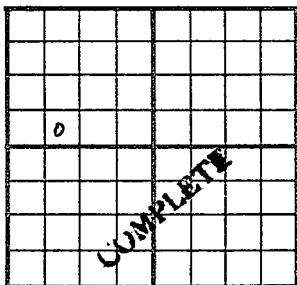

330 Ft. From S Line NW
990 Ft. From W Line Quarter
 1st. Report
 Completion JUL 23 1952
 Remarks

Spudding Date 6-14-52

Drlg. Data Oil well TD 3825
8" @ 1125 Heeb. 3402 Br. line 3474
Lans. 3489 DST 3496-3510 open 1 hr.
Rec. 950' sw 1200# Marm. 3708
Arb. 3763 TD 3825 5" @ 3822
CO to 3825 S/ $1\frac{1}{2}$ boph 500 A
S/ 7 boph 6% water
Comp. 72 bopd

J. G. McGEHEE