


Section 27 Township 19 Range 16-W

Well No. #5 Rankin

Company Ben Brack
Ryan Pool

25

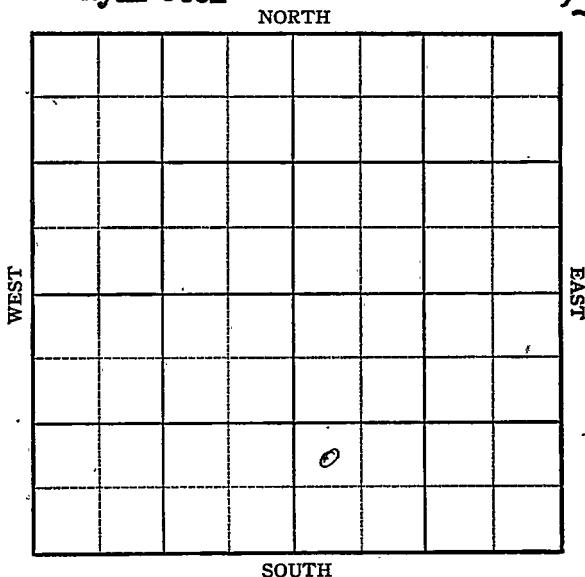

Rush

KANSAS

Sec. 27 Twp. 19 R. 16W

Well No. #5 Rankin Farm

Ben Brack

Company

Ryan Pool (Brack, Contr.)


NORTH

_____ Ft. from N. Line

990' Ft. from S. Line

_____ Ft. from E. Line

330' Ft. from W. Line

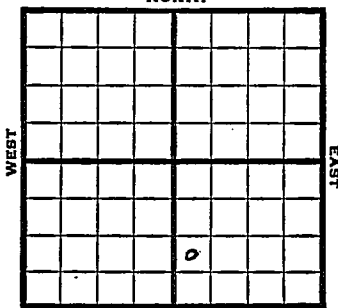

NW SW SE

SOUTH

1949 Elev. 2032' REPORT

11/16 Surface Hole

11/23 8" @ 850'

Drlg 3150'

11/29 Lansing 3434'
Arb. 3725'-70'

TD 3770'

5" @ 3760'

12/7 TD 3776'

1950
2/22

8" @ 850'

5" @ 3760'

Lans 3434'

Arb 3745'

Flow 115 BOPD

TD 3794'

COMPLETED

Kansas

Map No. _____ Sec. 27 Twp. 19 R. 16WWell No. 5 Rankin

_____ Ben Brack _____ Company

_____ Brack _____ Contractor

NW SW SE

FIRST REPORT
SECTION PLAT

		o	

_____ Ft. from N. Line

990 Ft. from S. Line

_____ Ft. from E. Line

330 Ft. from W. Line

Rush County

Location _____

Rig up _____

Drilling and Remarks:

surface hole

RECORD

Cased _____ in., _____ ft.

Sand _____

Gas _____

Oil _____

Total Depth _____

PRODUCTION

1st 24 hrs. Nat. _____

1st 24 hrs. after shot _____

Gas _____ Cu. Ft.

Dry Hole _____

Abandoned _____

Date

NOV 16 1949

19

S. J. LEWIS

Scout

Map No. _____ Sec. 27 Twp. 19 R. 16W

Well No. 5 Rankin

Ben Brack Company

Contractor

NW SW SE

E. 2032
SECTION PLAT

_____ Ft. from N. Line

990 Ft. from S. Line

_____ Ft. from E. Line

330 Ft. from W. Line

COMPLETE			
		o	

Rush County

Location _____

Rig up _____

Drilling and Remarks:

8" @ 850
5" @ 3760
Lans 3434
Ant 3745
Flow 115 BOPD

RECORD

Cased _____ in., _____ ft.

Sand _____

Gas _____

Oil _____

Total Depth 3794

PRODUCTION

1st 24 hrs. Nat. _____

1st 24 hrs. after shot _____

Gas _____ Cu. Ft.

Dry Hole _____

Abandoned _____

Date

FEB 22 1950 19

J. E. TYRA Scout