


Section 27 Township 19 Range 16W

Well No. #6 Rankin Est.

Company Ben Brack

10

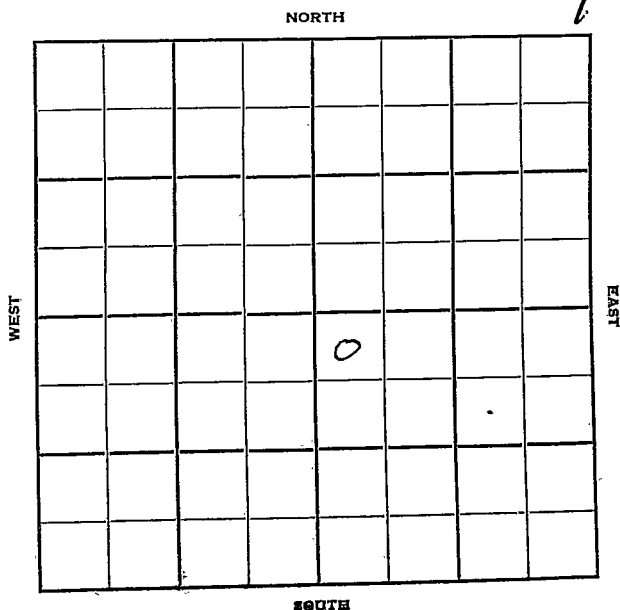

Rush

KANSAS

Sec. 27 Twp. 19 R. 16W ☒

Well No. #6 Rankin Est. Farm

Ben Brack Company

K & A Drlg. Contractor

Ryan Pool


330' Ft. from N. Line

Ft. from S. Line

Ft. from E. Line

330' Ft. from W. Line

NW NW SE

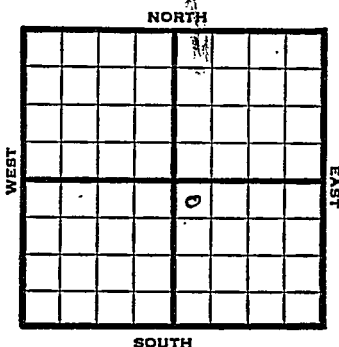

1950

Elev 2032

REPORT

1/25

Drlg. 615'

5/24

8" @ 810

Anhy 1080

Lans 3441

Cong 3742

Arb 3756-64

DST 3757-64

rec mud

5" @ 3759

DST 3742-50

open $\frac{1}{2}$ hr, rec 25' mud

TD 3800

Comp for SWD

Completed

COMPLETED

1951

O. W. D. D

1/31

Arb. 3756-58 5" @ 3759

Drlg. 3938'

2/21

SWD well TD 4299

Arb. 3756-58 5" @ 3759

Gr. wash 4276 Granite 4299 TD

Comp. for SWD

ABANDONED

Map No. _____ Sec. 27 Twp. 19 R. 16WWell No. 6 Rankin Est.

_____ Ben Brack _____ Company

_____ Contractor


NW NW SE

SECTION PLAT

330 Ft. from N. Line

_____ Ft. from S. Line

_____ Ft. from E. Line

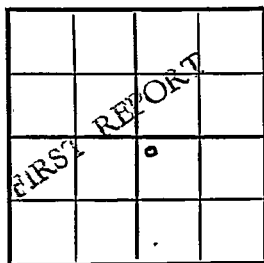330 Ft. from W. Line

Rush County

Location _____

Rig up _____

Drilling and Remarks:

drlg. 615

RECORD

Cased _____ in., _____ ft.

Sand _____

Gas _____

Oil _____

Total Depth _____

PRODUCTION

1st 24 hrs. Nat. _____

1st 24 hrs. after shot _____

Gas _____ Cu. Ft.

Dry Hole _____

Abandoned _____

Date

JAN 25 1950 19 J. E. TYRA Scout

Kansas

Map No. _____ Sec. 27 Twp. 19 R. 16WWell No. 6 Rankin Est.Ben Brack Company


Contractor

NW NW SE

E1.2032
SECTION PLAT330 Ft. from N. Line

Ft. from S. Line

Ft. from E. Line

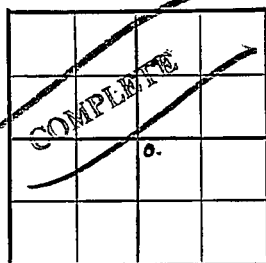330 Ft. from W. LineRush

Location _____

Rig up _____

Drilling and Remarks:

8" c 810
 anhy 1080
 Lard. 3441
 Cong. 3742
 arb. 3756-64
 DST. 3757-64
 Rec. mud
 5" c 3759

RECORD

Cased _____ in., _____ ft.

Sand _____

Gas _____

Oil _____

Total Depth _____

PRODUCTION

1st 24 hrs. Nat. _____

1st 24 hrs. after shot _____

Gas _____ Cu. Ft.

Dry Hole _____

Abandoned _____

Date

MAY 24 1950

19

*J. E. TYRA Scout

DST 3742-50

open 1/2 hr.

Rec. 25' mud


T.D. 3800

Comp. for Sup

1950

Scout Cards
Land Small Map
Land Wall Map
Tracings
France Map
Pierce Map
Misc.

JUN 5

 

County Rush State Kansas
 Sec. 27 (Blk. 19) (Sur. 16W) Map No.
 Operator Kewanee Oil (was Brack)
 Well No. 6 Farm Rankin
 Elev. 2032 Location NW NW SE

FIRST REPORT

330 Ft. From N Line SE
 330 Ft. From W Line Quarter
 Ist. Report JAN 31 1951
 Completion O. W. D. D.
 Remarks OWDD for SWD
K & A Drlg. - Contr.

Spudding Date
 Drlg. Data Ryan Pool

Arb. 3756-88 5" @ 3759 drlg. 3938

J. E. TYRA

J. E. TYRA