

Section 27 Township 19 Range 16 W

Well No. 7 Rankin est

Company Ben Brack Oil

9

NORTH

						0	

WEST

EAST

SOUTH

Sec. 27 Twp. 19 R. 16W ✓

Well No. #7 Rankin est Farm

Ben Brack Oil Company

Contractor


330 Ft. from N. Line

_____ Ft. from S. Line

990 Ft. from E. Line

_____ Ft. from W. Line

NW NE SE

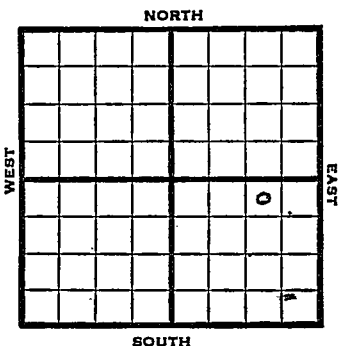

1950

Elev 2045

REPORT

5/10

8" @ 830
Anhy 1095
Drlg. 1900

6/28

TD 3799
8" @ 830
Anhy 1095
5½" @ 3777
250 acid
Comp 125 bopd
Completed

COMPLETED

Ka
KansasMap No. _____ Sec. 27 Twp. 19 R. 16WWell No. 7 Rankin est._____ Ben Brack Oil _____ Company

_____ Contractor

NW NE S~~6~~330 Ft. from N. Line

_____ Ft. from S. Line

000 Ft. from E. Line

_____ Ft. from W. Line

SECTION PLAT

FIRST REPORT			
			o

Rush

Location _____

Rig up _____

Drilling and Remarks:

8" @ 830

Anhy 1095

Drlg. 1900

RECORD

Cased _____ in., _____ ft.

Sand _____

Gas _____

Oil _____

Total Depth _____

PRODUCTION

1st 24 hrs. Nat. _____

1st 24 hrs. after shot _____

Gas _____ Cu. Ft.

Dry Hole _____

Abandoned _____

Date

MAY 1 1950

J. E. TYRA

19

Scout


Kansas

Map No. _____ Sec. 27 Twp. 19 R. 16WWell No. 7 Rankin Est._____ Ben Brack Oil _____ Company_____ Contractor
NW NE SEE1. 2045
SECTION PLAT_____ 330 Ft. from N. Line

_____ Ft. from S. Line

_____ 990 Ft. from E. Line

_____ Ft. from W. Line

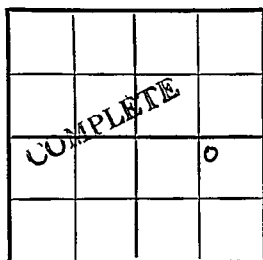

Rush County

Location _____

Rig up _____

Drilling and Remarks:

8" C 830

Anhy 1095

5 $\frac{1}{2}$ " C 3777

TD 3799

250 acid

Comp. 125 bopd

RECORD

Cased _____ in., _____ ft.

Sand _____

Gas _____

Oil _____

Total Depth _____ 3799

PRODUCTION

1st 24 hrs. Nat. _____

1st 24 hrs. after shot _____

Gas _____ Cu. Ft.

Dry Hole _____

Abandoned _____

Date

JUN 28 1950

19

J. E. TYRA Scout