


Section 27 Township 19 Range 15 W

Well No. # 1 Jurgenson

Company L. D. Sargent

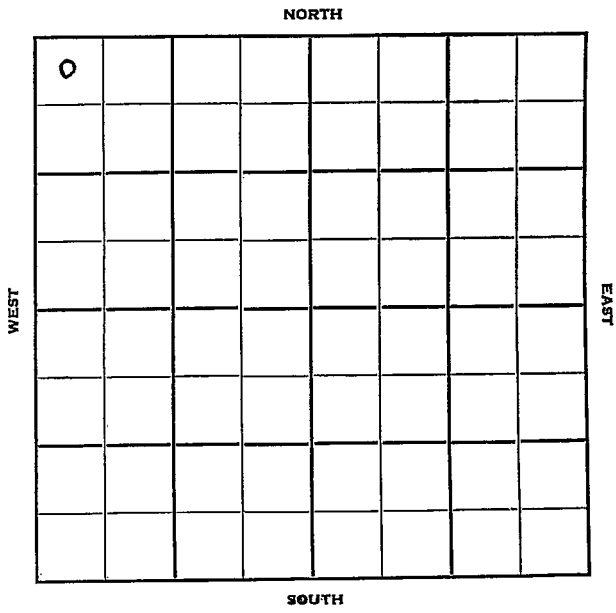

Barton

KANSAS

Sec. 27 Twp. 19 R. 15W

Well No. #1 Jurgenson Farm

L. D. Sargent Company

Wildcat Contractor


330' Ft. from N. Line

Ft. from S. Line

Ft. from E. Line

330' Ft. from W. Line

NW NW NW

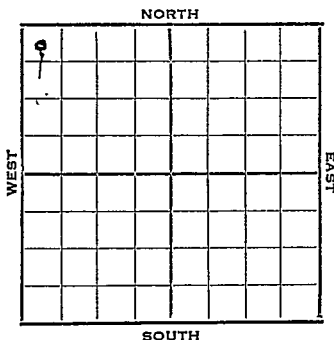

1951

Elev. 1933' REPORT

12/19 RUR

1952
2/6 Anhy 897 TD 3710

2/13 No report

2/20 Spud 12-19-51
D & A TD 3710'
Anhy 897' 8" @ 905' TD 3710'
D & A

ABANDONED

County Barton State Kansas

Sec. 27 (Blk.) 19 (Sur.) 15W Map No.

Operator L. D. Sargent

Well No. 1 Farm Jurgenson

Elev. Location NW NW NW

10									

330 Ft. From N Line NW

330 Ft. From W Line Quarter

1st. Report DEC 1 9 1951

Completion


Remarks

Spudding Date

Drlg. Data Wildcat

RUR

J. E. TYRA

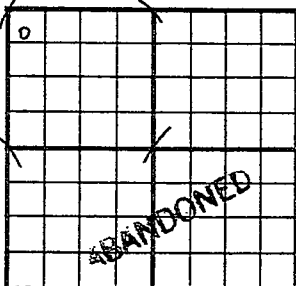County Barton State KansasSec. 27 (Blk.
Twp.) 19 (Sur.
Rge.) 15W Map No.Operator L. D. SargentWell No. 1 Farm JurgensonElev. 1933 Location NW NW NW330 Ft. From N Line NW330 Ft. From W Line Quarter1st. ReportCompletion FEB 20 1952Remarks WildcatSpudding Date 12-19-51Drlg. Data D & A TD 3710Anhy 897 8" @ 905 TD 3710D & A

J. G. McGEHEE