


Barton

Section 27 Township 19 Range 15 W

Well No. # 1 Jurgenson

Company Schermerhorn Oil

NORTH

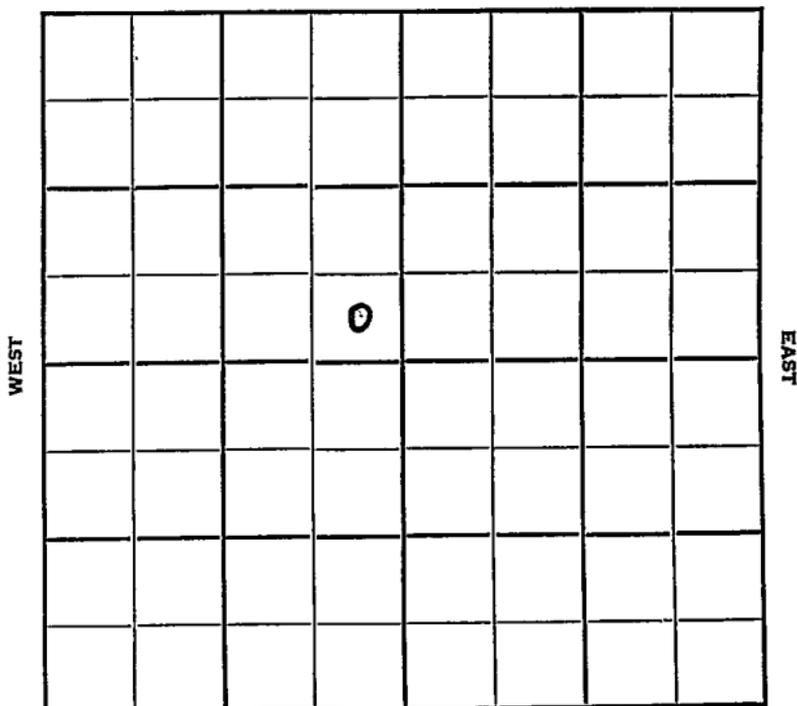

SOUTH



Sec. 27 Twp. 19 R. 15 W

Well No. # 1 Jurgenson Farm

Schermerhorn Oil Company

Badger Drlg. Contractor

Pendergast Pool


\_\_\_\_\_ Ft. from N. Line

330 Ft. from S. Line

330 Ft. from E. Line

\_\_\_\_\_ Ft. from W. Line

SE SE NW

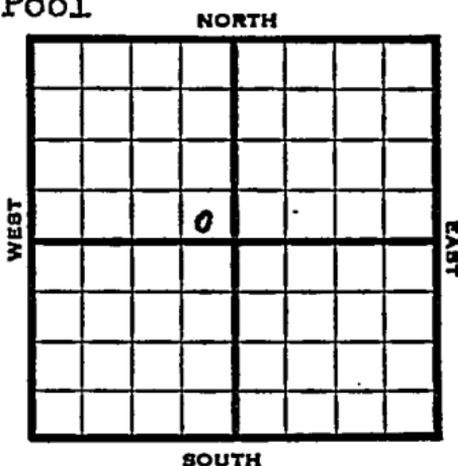

1953

Elev. 1927' REPORT

6/17 Spud 6-8-53  
8" @ 900 Anhy 895'  
Drlg. 3075'

6/24 N.R. ...

7/1 Arb 3614  
RTD 3620'  
5" @ 3617'

7/8 CO 3620, 150A  
FU 1900' fluid, 50% W

10/28

Spud 6-8-53 D & A TD 3620'  
8" @ 900 Anhy 895' Heeb 3182'  
Tor. 3197' Doug. 3210'  
Br. lime 3262' KC 3273'  
DST 3401-10 open 20 min rec 15' mud  
DST 3410-25 open 1 hr rec 15' mud  
B KC 3498' Arb. 3592'  
DST 3589-3620 open 1 hr 3/4 MCFG  
80' HO & GCM, 220' oil, 60' oil &  
wtr. 120' wtr. 1060# TD 3620'  
5" @ 3617' CO to 3620 FU 1900'  
fluid. 35% oil 300 A S/10 BFPH  
1/3 oil. PB 3614' 67/3595-3611  
SO W & G 500 A S/100 BO 3 hr.  
1 1/4 MCFG F/3 BO 30 BW  
D & A

**ABANDONED**

County Barton State Kansas

Sec. 27 (Blk. Twp.) 19 (Sur. Rge.) 15W Map No.

Operator Schermerhorn Oil

Well No. 1 Farm Jurgenson

Elev. \_\_\_\_\_ Location SE SE NW



330 Ft. From S Line NW

330 Ft. From E Line Quarter

1st. Report JUN 17 1953

Completion \_\_\_\_\_

Remarks \_\_\_\_\_

Badger Drlg. - Contr.

Spudding Date 6-8-53

Drlg. Data Pendergast Pool

8" @ 900 Anhy 895 drlg. 3075

J. G. McGEHEE

County Barton State Kansas  
 Sec. 27 (Blk. 19) (Sur. 15W) (Twp. 19) (Rge. 15W) Map No.  
 Operator Schermerhorn Oil  
 Well No. 1 Farm Jurgenson  
 Elev. 1927 Location SE SE NW

330 Ft. From S Line NW330 Ft. From E Line Quarter

1st. Report

Completion OCT 28 1953Remarks Pendergast PoolBadger Drlg. - Contr.Spudding Date 6-8-53Drlg. Data D & A TD 36208" @ 900 Anhy 895 Heeb. 3182Tor. 3197 Doug. 3210 Br. lime 3262KC 3273 DST 3401-10 open 20 min.Rec. 15' mud DST 3410-25 open 1 hr.Rec. 15' mud B KC 3498 Arb. 3592DST 3589-3620 open 1 hr. 3/4 mcfg80' ho & gcm 220' oil 60' oil & wtr.120' wtr. 1060# TD 3620 5" @ 3617CO to 3620 FU 1900' fluid 35% oil300 A S/ 10 bfph 1/3 oil PB 361467/ 3595-3611 SO W & G 500 AS/ 100 bo 3 hr. 1 1/2 mcfg F/ 3 bo 30 bwD & A

J. G. McGEHEE