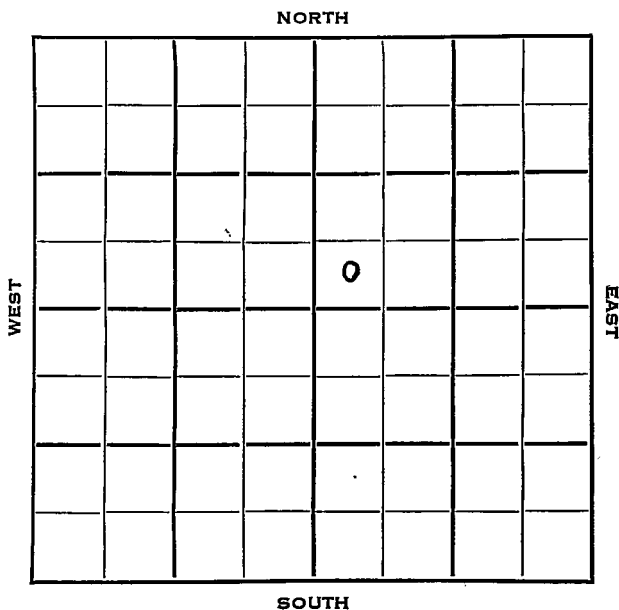


FORM 51

Barton

Section 27 Township 19 Range 15 WWell No. # 1 PendergastCompany Schermerhorn Oil

Barton

KANSAS

27

19

15W

Sec. _____ Twp. _____ R. _____

#1 Pendergast

Well No. _____ Farm _____

Schermerhorn Oil

Company _____

Badger

Contractor _____

Wildcat

Ft. from N. Line

330

Ft. from S. Line


Ft. from E. Line

330

Ft. from W. Line

SW SW NE

Phillips - DHM

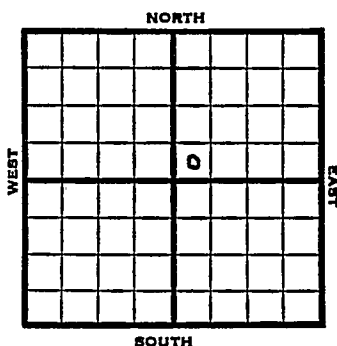

1953

Elev. 1926' REPORT

4/15

RUR

4/23

Drilg. 2795'

4/30

NR

5/7

5" @ 3500'

5/21

20/3402-06, NS

5/3396-97, NS

45/3397-3402 1 BOPH 550A

S/20 BOPH, POP

5/28

N.R.

6/3

Spud 4-14-53 Oil well TD 3633

Anhy 898 Anhy 901 Top. 2926

Heeb. 3176 Tor. 3191 Doug. 3203

Br. lime 3258' Lans. 3266

DST 3394-3410 open 1 hr rec 780' gas

360' oil, 60' HO & GCM 1140#

B-KC 3490 Marm. 3501 Cong. 3542

Arb. 3580

DST 3582-85, failed.

DST 3583-90 open 1 hr rec 30' GCM

1040#

DST 3590-3620 open 1 hr rec 125' GCM

810# PreCamb. 3627'

DST 3620-33 open 1 hr rec 180' mud

60' sul. wtr. 1100# TD 3633

OVER

1953

6/3

(Information continued)

5" @ 3500 20/3402-06

5/3396-97 45/3397-3402 1 BOPH

550 A S/20 BOPH

Comp. 106 BOPD

COMPLETED

County Barton State KansasSec. 27 (Blk. Twp.) 19 (Sur. Rge.) 15W Map No.Operator Schermerhorn OilWell No. 1 Farm PendergastElev. Location SW SW NE

330 Ft. From S Line NE330 Ft. From W Line Quarter1st. Report APR 15 1953

Completion

Remarks Phillips - IHMBadger - Contr.

Spudding Date

Drig. Data WildcatRUR

