

KANSAS


Rush

Section 27 Township 19 Range 16W

Well No. 2 Thalheim

Company Ben Brack
Ryan

12

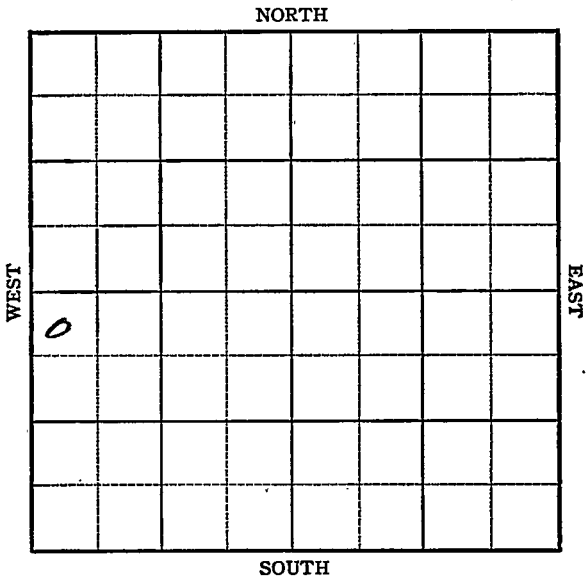

Sec. 27 Twp. 19 R. 16W

Well No. #2 Thalheim Farm

Ben Brack Company

Ryan Pool


NORTH

330' Ft. from N. Line

_____ Ft. from S. Line

_____ Ft. from E. Line

330' Ft. from W. Line

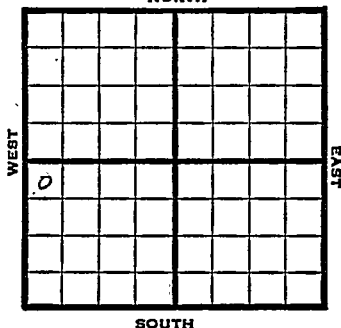

NW SW

1949 Elev. 2065' REPORT

9/7 RUR
 9/14 8" @ 815'
 Drlg 1600'
 9/21 Drlg. 3550'
 9/28 Lansing 3470'
 Arb. 3737
 TD 3800'
 5" @ 3793'
 10/5 TD 3804'
 500 acid
 Flow 57 bbls oil PH 3 hrs.
 10/12 " "
 10/19 " "
 10/26 Arb 3737'
 5" @ 3789'
 Pump 40 oil Pot.
 TD 3804'

COMPLETED

Map No. _____ Sec. 27 Twp. 19 R. 16W

Well No. 2 Thalheim

Ben Brack Company

Contractor

NW SW

FIRST REPORT
SECTION PLAT

330 Ft. from N. Line

_____ Ft. from S. Line

_____ Ft. from E. Line

330 Ft. from W. Line

o			

Rush County

Location _____

Rig up _____

Drilling and Remarks:

R U R

RECORD

Cased _____ in., _____ ft.

Sand _____

Gas _____

Oil _____

Total Depth _____

PRODUCTION

1st 24 hrs. Nat. _____

1st 24 hrs. after shot _____

Gas _____ Cu. Ft.

Dry Hole _____

Abandoned _____

Date

SEP 7 1949 19

S. J. LEWIS

Scout

Kansas

Map No. _____ Sec. 27 Twp. 19 R. 16WWell No. 2 ThalheimBen Brack Company

COMPLETE

Contractor

NW SW

E12065
SECTION PLAT330 Ft. from N. Line

_____ Ft. from S. Line

_____ Ft. from E. Line

330 Ft. from W. Line

o			

Rush County

Location _____

Rig up _____

Drilling and Remarks:

Per 37375" @ 278'Per 40 oil Co39 2/84

RECORD

Cased _____ in., _____ ft.

Sand _____

Gas _____

Oil _____

Total Depth 3804

PRODUCTION

1st 24 hrs. Nat. _____

1st 24 hrs. after shot _____

Gas _____ Cu. Ft.

Dry Hole _____

Abandoned _____

Date

OCT 26 1949 19S. J. LEWIS Scout