
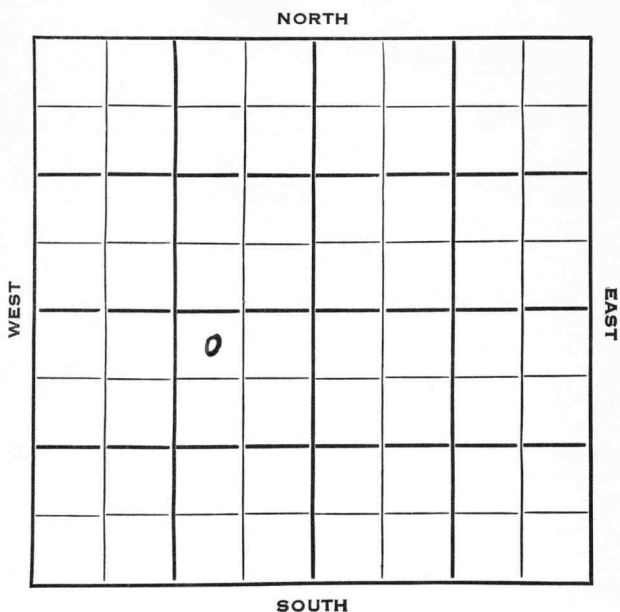


Section 28 Township 19 Range 11 WWell No. # 2 SchwanbornCompany Eldorado Ref.

Sec. 28 Twp. 19 R. 11WWell No. #2 Schwanborn FarmElDorado Ref. CompanyPabco Drlg. ContractorThill Pool330 Ft. from N. Line Ft. from S. Line990 Ft. from E. Line Ft. from W. Line

NW NE SW

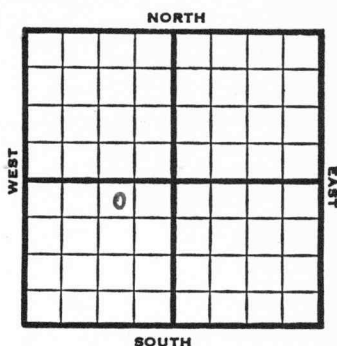

1953 Elev. 1783' REPORT

4/15 Spud 4-13-53
8" @ 255'4/23 Heeb 2916'
DST 2853-72, 1 hr, 28' M, 2' oil
180# Br 11 3034' Lans 3051'
DST 3052-82, 3/4 hr, 180' O & GCM
75' oil 870#
DST 3107-29, F/oil in 10" 950#
Drlg. 3135'4/30 DST 3190-3202, 1/2 hr, 260' gas,
70' O & GCM, 50' MCO 780#
Cong. 3322 Arb. 3345 RTD 3748
5" @ 3347 DD 3353 FU 100 GO 12 hrs
DD

5/7 Testing

5/13 Spud 4-13-53

Oil Well

TD 3361'

8" @ 255'

Heeb 2916,

DST 2853-72 opn 1 hr, rec 28' mud, 2'
oil, 180# Br. Lime 3034, Lans 3051DST 3052-82 open 3/4 hr. rec 180' o &
gcm 75' oil 870#

DST 3107-29 F oil in 10 min. 950#

DST 3190-3202 opn 1/2 hr, rec 260' gas,
70' o & gcm. 50' mco, 780#

OVER

1953

Information brought forward.

5/13 Cong 3322, Arb 3345,
TD 3348
5" @ 3347'
DD 3349 DD 3353 FU 100' go 12 hr.
DD 3361 FU 50' wtr. 75' oil PB 3300
24/ 3258-64 B/ 35 go 1 hr.
500 A S/ $2\frac{1}{2}$ boph 7 hr. 75' wtr.
125' oil 13 hr. PB 3230 35/ 3194-3200
1000 A F 45 bo 1 hr. F 68 bo 2nd hr.
F/ 50 boph PB 3160 47/ 3120-28
F/ 50 boph 2 hr. F/ 51 boph 20 hr.
Comp. 1930 bopd.

COMPLETED

County Barton State Kansas

Sec. 28 (Blk.) 19 (Sur.) 11W Map No.

Operator Eldorado Ref.

Well No. **2** Farm **Schwanborn**

Elev.	Location	NW	NE	SW
-------	----------	----	----	----

FIRST REPORT

330 Ft. From N Line SW

990 Ft. From E Line Quarter

1st. Report APR 15 1953

Completion

Remarks

Pabco Drlg. - Contr.

Spudding Date **4-13-53**

Drig. Data Thill Pool


8¹²@ 255

APR 17 1953

Scout Cards
Land Small Map
Land Wall Map
Tracings
France Map
Pierce Map
Misc.

Orig. Data

County Barton State Kansas
 Sec. 28 (Blk. 19 (Sur. 11W Map No.)
 (Twp.) (Rge.)
 Operator Eldorado Ref.
 Well No. 2 Farm Schwanborn
 Elev. 1783 Location NW NE SW

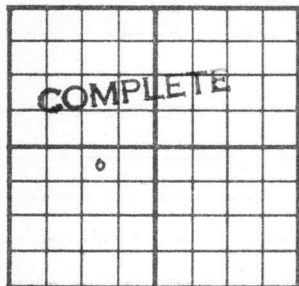

330 Ft. From N Line SW
990 Ft. From E Line Quarter

1st. Report

Completion MAY 13 1953

Remarks Thill Pool
Pabco Drlg. - Contr.

Spudding Date 4-13-53

Drlg. Data Oil well TD 3361

8" @ 255 Heeb. 2916 DST 2853-72

open 1 hr. Rec. 28' mud 2' oil 180#

Br. lime 3034 Lans. 3051 DST 3052-82

open 3/4 hr. Rec. 180' o & gcm 75' oil

870# DST 3107-29 F/ oil in 10 min.

950# DST 3190-3202 open 1/2 hr. Rec.

260' gas 70' o & gcm 50' mco 780#

Cong. 3322 Arb. 3345 TD 3348

5" @ 3347 DD 3349 DD 3353 FU 100' go

12 hr. DD 3361 FU 50' wtr. 75' oil

PB 3300 24/ 3258-64 B/ 35 go 1 hr.

500 A S/ 2 1/2 boph 7 hr. 75' wtr.

125' oil 13 hr. PB 3230 35/ 3194-3200

1000 A F/ 45 bo 1 hr. F/ 68 bo 2nd hr.

J. G. McGEHEE

MAY 19 1953

Scout Cards
Land Small Map
Land Wall Map
Tracings
France Map
Pierce Map
Misc

EF

3

Comp. 1930-1950
E/50 bopn 2 hr.
E/50 bopn 20 hr.
47/3120-28

Orig. Data