


Section 28 Township 19 Range 11W

Well No. 3 Schwanborn

Company El Dorado Ref.

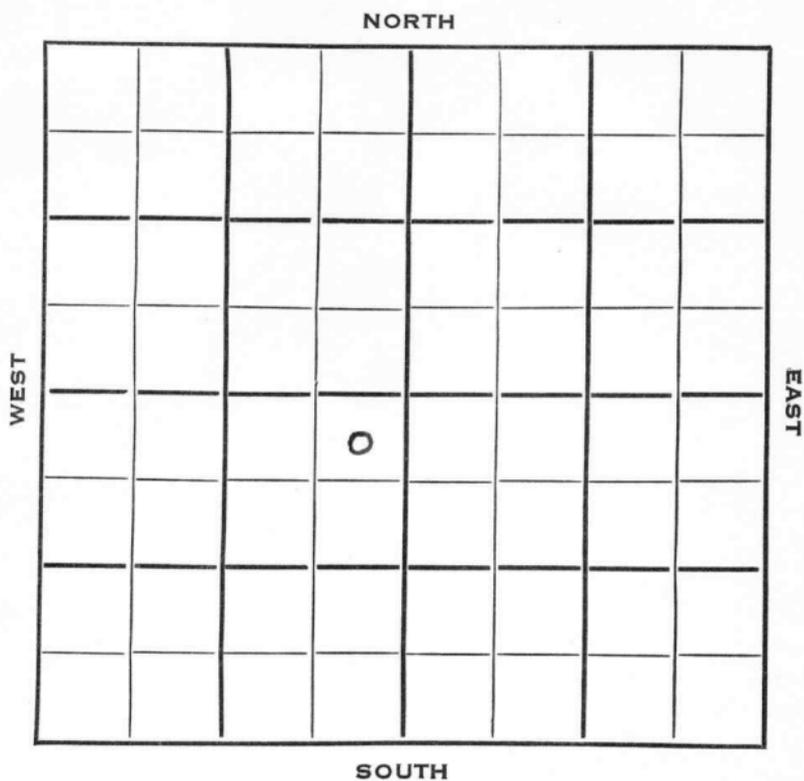

SEC.	TWP.	R.
28	19	11W ✓

WELL NO. _____
 3 Schwanborn FARM

COMPANY _____
 El Dorado Ref.

CONTRACTOR _____


Thill Pool

330 Ft. from N. Line

_____ Ft. from S. Line

330 Ft. from E. Line

_____ Ft. from W. Line

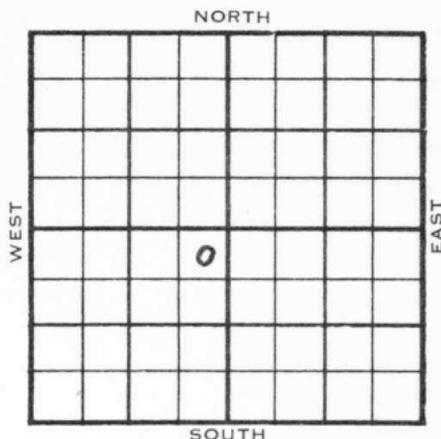

NE NE SW

	ELEVATION	REPORT
1953	1781'	

9/16 Cellar & Pits

9/23 8" @ 249 w/175
 Anhy 552'
 Drlg. 2975'

10/14 Spud 9-16-53 Oil well TD 3363
 8" @ 249 Anhy 552 Heeb 2924
 Tor. 2940 Br lime 3045 Lans 3064
 DST 3067-91 open 1 hr rec 60' SO & GCM
 600' gas. 220#
 DST 3123-41 open 1 hr rec 1340' oil
 30' mud, 500' wtr. 780#
 DST 3199-3217 open 1 hr rec 240' gas,
 10' GCM 80#
 DST 3265-81 open 1 hr. rec 30' SOCM
 45# TD 3363 5" @ 3223
 Cong 3341 18/3128-31 FU 1325' fluid
 12 hr. S/3½ BFPH 60% wtr.
 S/8 BO 3 BW 3½ hr.
 FU 1300' fluid 12 hr.
 Comp. 159 BOPD 10% wtr.

COMPLETED

County Barton State Kansas

Sec. 28 (Blk.) 19 (Sur.) 11W Map No.

Operator Eldorado Ref.

Well No. 3 Farm Schwanborn

Elev. 1781 Location NE NE SW

COMPLETE									

330 Ft. From N Line SW

330 Ft. From E Line Quarter

1st. Report

OCT 14 1953

Completion

Remarks Thill Pool

Spudding Date 9-16-53

Drlg. Data Oil well TD 3363

8" @ 249 Anhy 552 Heeb. 2924

Tor. 2940 Br. lime 3045 Lans. 3064

DST 3067-91 open 1 hr. Rec. 60' so &

gcm 600' gas 220# DST 3123-41

open 1 hr. Rec. 1340' oil 30' mud

500' wtr. 780# DST 3199-3217

open 1 hr. Rec. 240' gas 10' gcm 80#

DST 3265-81 open 1 hr. Rec. 30' so cm

45# TD 3363 5" @ 3223 Cong. 3341

18/ 3128-31 FU 1325' fluid 12 hr.

S/ 3¹/₂ bfph 60% wtr. S/ 8 bo 3 bw 3¹/₂ hr

FU 1300' fluid 12 hr.

Comp. 159 bopd 10% wtr.