


Section 28 Township 19 Range 11 W

Well No. # 5 Schwanborn

Company Elreco

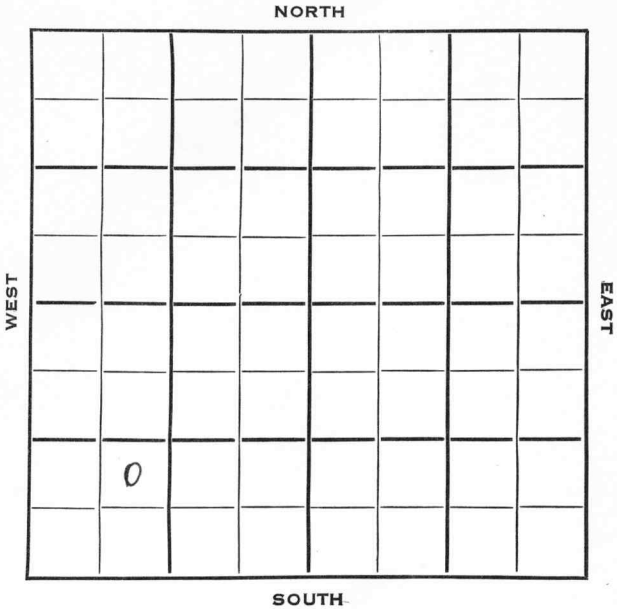

Barton

SEC.	TWP.	KANSAS
28	19	11 W ✓

WELL NO.

5 Schwanborn

COMPANY FARM

Elreco

CONTRACTOR

Sterling


Anton Pool

_____ Ft. from N. Line

990 _____ Ft. from S. Line

_____ Ft. from E. Line

990 _____ Ft. from W. Line

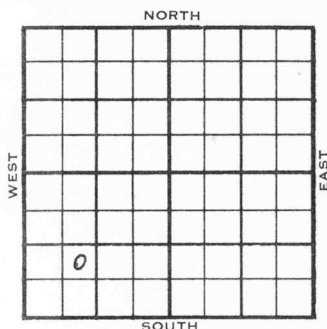

NE SW SW

1954	ELEVATION 1785'	REPORT
4/7 5/12	Location Spud 4-7-54 Oil Well TD 3348' 8" @ 245' Anhy 565', Heeb 2919', Tor 2936', Doug 2951', Br line 3040', Mans 3059' DST 3059-87', opn 1 3/4 hrs., rec. 3000' gas, 140' ho & gcm, 80' muddy wtr, 40' wtr. DST 3112-36', opn 1 hr., F/oil 19", 689# DST 3187-3205', opn 1 hr., rec. 13' mud, 0# Cong 3319', Re-Arb. 3340', Arb. 3344', TD 3346' 5" @ 3345' CO to 3346', 50A B/10 gwph DD 3348' 15 gwph PB 3300', 24/3130-36, F/18 bo 1 hrs. F 19 bo 2nd hr., 500A, S/23 bo F 43 bo 1 hr., F 39 bo 2nd hr., F 13 1/2 bo 20" Comp. 2308 bopd	

County Barton State Kansas
 Sec. 28 (Blk.) 19 (Sur.) 11W Map No.
 Operator Elreco
 Well No. 5 Farm Schwanborn
 Elev. _____ Location NE SW SW

990 Ft. From S Line SW
990 Ft. From W Line Quarter
 Ist. Report APR 7 1954

Completion _____

Remarks _____

Spudding Date _____


Drlg. Data _____

Anton Pool

Location

J. G. McGEHEE

County Barton State Kansas
 Sec. 28 (Blk. 19) (Sur. 11W) Map No. 19
 Operator Elreco
 Well No. 5 Farm Schwanborn
 Elev. 1785 Location NE SW SW

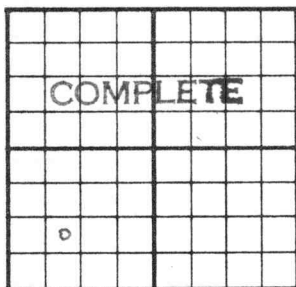

990 Ft. From S Line SW
990 Ft. From W Line Quarter

1st. Report

Completion MAY 12 1954

Remarks Anton Pool

Sterling - Contr.

Spudding Date 4-7-54

Drlg. Data Oil well TD 3348

8" @ 245 Anhy 565 Heeb. 2919

Tor. 2936 Doug. 2951 Br. lime 3040

Lans. 3059 DST 3059-87 open 1 3/4 hr.

Rec. 3000' gas 140' ho & gcm 80' muddy

wtr. 40' wtr. DST 3112-36 open 1 hr.

F/ oil 19 min. 689# DST 3187-3205

open 1 hr. Rec. 13' mud 0# Cong. 3319

ReArb. 3340 Arb. 3344 TD 3346

5" @ 3345 CO to 3346 50 A B/ 10 gwph

DD 3348 15 gwph PB 3300 24/ 3130-36

F/ 18 bo 1 hr. F/ 19 bo 2nd hr.

500 A S/ 23 bo F/ 43 bo 1 hr.

F. 39 bo 2nd hr. F/ 13 1/2 bo 20 min.

Comp. 2308 bopd

J. G. McGEHEE