


Section 28 Township 19 Range 11W

Well No. #6 Schwanborn

Company Eldorado Ref.

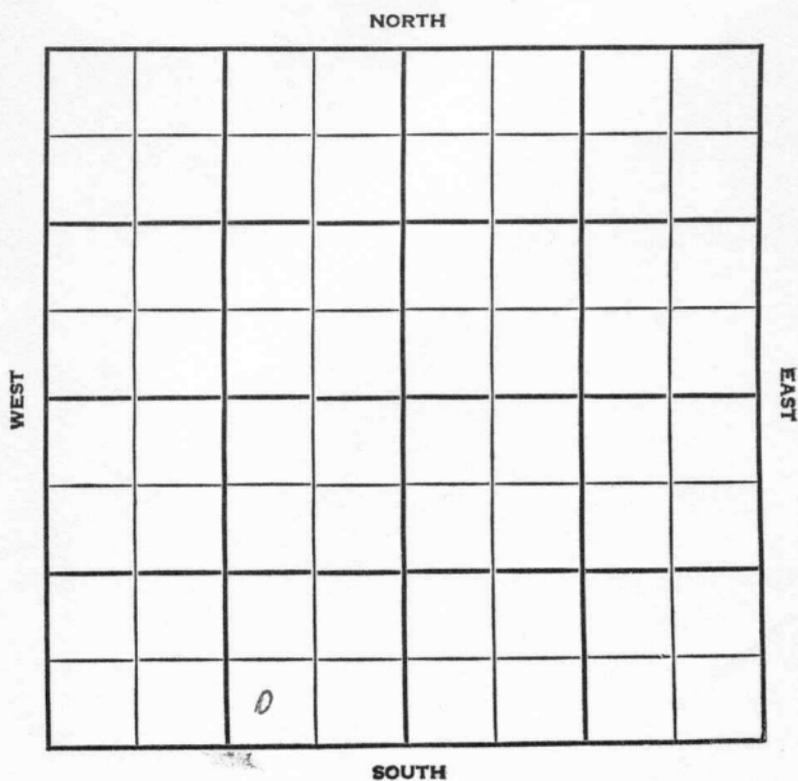

Barton KANS 'S


SEC.	TWP.	R.
28	19	11W

WELL NO. _____
 COMPANY 6 Schwanborn FARM

CONTRACTOR El Dorado Ref.

Lewis Drlg.
Thill Pool

_____ Ft. from N. Line
330 _____ Ft. from S. Line
990 _____ Ft. from E. Line
 _____ Ft. from W. Line

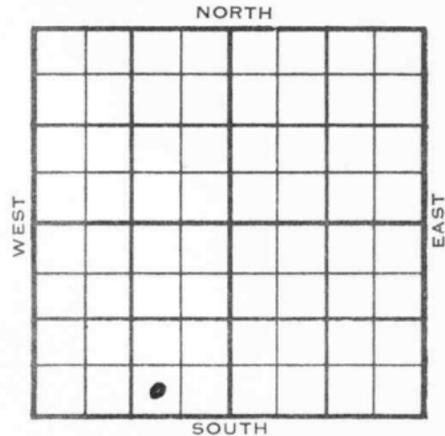

SW SE SW

	ELEVATION	REPORT
1955	1783'	
1/55		Spud 12-31-54 8-5/8" @ 253' Drlg. 2735'
2/23		Spud 12-31-54 - Oil Well TD 3353' 8-5/8" @ 253' Heeb. 2919', Tor. 2931', Doug. 2949', Doug. sd 2976', Br lime 3039', Lans. 3059' DST 3062-85', opn 33", gas to surface in 3" F/oil in 17", 870# DST 3119-35', opn 1 hr., gas to surface in 6", rec. 1500' oil 420# DST 3139-44', opn 1 hr., GTS in 30", rec. 180' mo & 60' oil, 730# DST 3189-3207', opn 1 hr., rec. 35' mud, 0# DST 3227-37', opn 1 hr., rec. 25' mud, 300# Cong. 3321', Arb. 3336' TD 3339' 5" @ 3337

OVER

(Information Brought Forward)

1955
2/23

B/¼ BO 3 BW 12 hrs.

DD 3353'

B 5 gf 30", 25 to 30% wtr.

SP 3250'

16/3134-38, 20/3121-26

FU 200' oil 15", 2000A

FU 1800' oil

S/56 bo 1 hrs., 26 bo 30"

Comp. 235 bopd

COMPLETED

JUN 10 1955

Scout Cards	12
Land Small Map	
Land Wall Map	
Tracing	3
France Map	
Pierce Map	
Misc.	

County Barton State Kansas

Sec. 28 (Blk. 19) (Sur. Rge.) 11W Map No.

Operator Eldorado Ref.

Well No. 6 Farm Schwanborn

Elev. 1783 Location SW SE SW

330 Ft. From S Line SW

990 Ft. From E Line Quarter

1st. Report

FEB 23 1955

Completion

Remarks Thill Pool

Lewis Drlg. - Contr.

Spudding Date 12-31-54

Drlg. Data Oilwell TD 3353

8 5/8" @ 253 Heeb. 2919 Tor. 2931

Doug. 2949 Doug. sd. 2976 Br. lime 3039

Lans. 3059 DST 3062-85 open 33 min.

gas to surface in 3 min. F/ oil in 17 min.

870# DST 3119-35 open 1 hr. gas to

surface in 6 min. Rec. 1500' oil 420#

DST 3139-44 open 1 hr. gas to surface

in 30 min. Rec. 180' mo & 60' oil 730#

DST 3189-3207 open 1 hr. Rec. 35' mud

0# DST 3227-37 open 1 hr. Rec. 25' mud

300# Cong. 3321 Arb. 3336 TD 3339

5" @ 3337 B/ 1/4 bo 3 bw 12 hr. DD 3353

B/ 5 gf 30 min. 25 to 30% wtr. SP 3250

16/ 3134-38 20/ 3121-26 FU 200' oil

FABEN GILSTRAP OVER

MAR 1 1955

Scout Cards	_____	70
Land Small Map	_____	
Land Wall Map	_____	
Tracings	_____	33
France Map	_____	
Pierce Map	_____	
Misc	_____	

15 min. 2000 A BU 1800' oil
S / 56 bo 1 hr. 26 bo 30 min.
Comp. 235 bo

Drig. Data