


Section 28 Township 19 Range 11W

Well No. 1 - Thill

Company Pabco Drlg

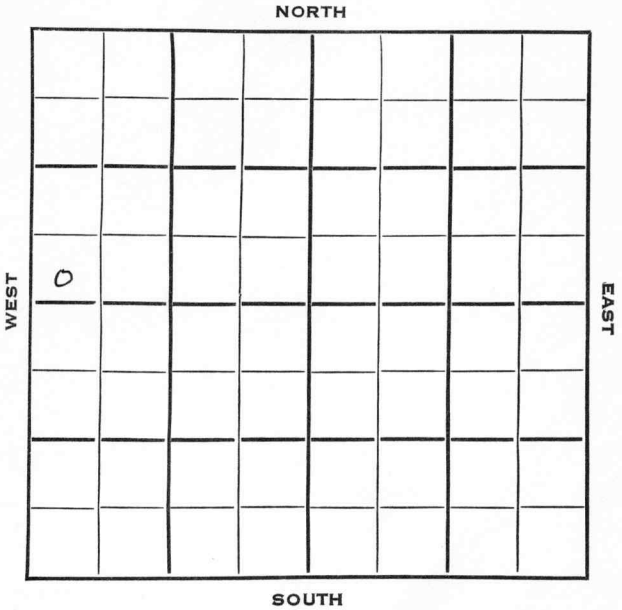

Sec. 28 Twp. 19 R. 11W

Well No. #1Thill Farm

Pabco Drlg. Company

Wildcat Contractor


Ft. from N. Line

330 Ft. from S. Line

Ft. from E. Line

330 Ft. from W. Line

SW SW NW  
Texas - DHM

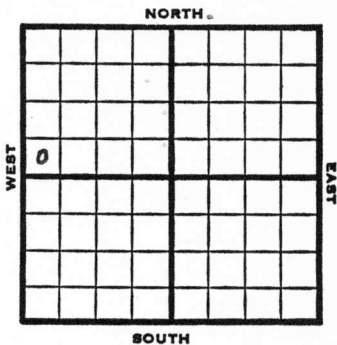

1953 Elev. 1786' REPORT


- 1/14 Location
- 1/22 8" @ 223,  
Anhy 595  
Drlg. 1195'
- 1/29 Heeb 2951' Br li 3060 Lans 3078  
DST 3210-20, 1 hr, 15' OCM, 170' oil  
1280# RTD 3366' 5" @ 3366'
- 2/5 42/3316-23 $\frac{1}{2}$  NS, 36/3281-87 W&SO  
PB 3292, 500A, S/10 BWPB, NS  
PB 3270, 48/3246-54, 3 BWPB  
24/3216-20, 22 goph, 10 hrs.,  
1000A, S/16 BOPB, 1700' off Btm  
POP
- 2/12 Cong 3350'
- 2/19 NR
- 2/26 "
- 3/12 NR
- 3/19 NR
- 3/26 P/17 BOPB
- 4/2 "

OVER

1953  
4/8

Spud 1-17-53 Oil well TD 3366  
8" @ 223 Anhy 595 Heeb 2951  
Br lime 3060 Lans 3078  
DST 3210-20 open 1 hr. rec 15' OCM  
170' oil, 1280# TD 3366  
5" @ 3366 42/3316-23 $\frac{1}{2}$  36/3281-87  
5 GW & SO PH PB 3292 500 A  
S/10 B<sup>W</sup>PH PB 3270 48/3246-54  
3 B<sup>W</sup>PH 24/3216-20 22 GOPH  
10 hr. 1000 A S/16 BOPH  
Cong. 3350 P/16 BOPH P/17 BOPH  
Comp. 312 BOPD

**COMPLETED**

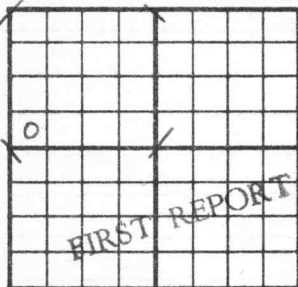County Barton State KansasSec. 28 (Blk. Twp.) 19 (Sur. Rge.) 11W Map No.Operator Pabco Drlg.Well No. 1 Farm ThillElev. Location SW SW NW330 Ft. From S Line NW330 Ft. From W Line Quarter1st. Report JAN 14 1952

Completion

Remarks Texas - DHM

Spudding Date

Drlg. Data WildcatLocation

JAN 16 1953

*TD*

Scout Cards	_____
Land Small Map	_____
Land Wall Map	_____
Tracings	_____
France Map	_____
Pierce Map	_____
Misc.	_____

*9*


County Barton State Kansas

Sec. 28 (Blk.) 19 (Sur.) 11W Map No.

Operator Pabco Drlg.

Well No. 1 Farm Thill

Elev. 1786 Location SW SW NW

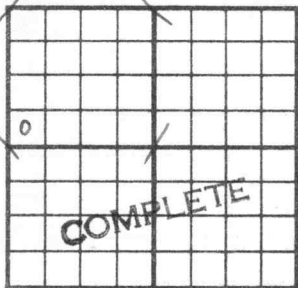

330 Ft. From S Line NW

330 Ft. From W Line Quarter

1st. Report

Completion APR 8 1953

Remarks Wildcat

Spudding Date 1-17-53

Drlg. Data Oil well TD 3366

8" @ 223 Anhy 595 Heeb. 2951

Br. lime 3060 Lans. 3078 DST 3210-20

open 1 hr. Rec. 15' ocm 170' oil

1280# TD 3366 5" @ 3366 42/ 3316-23 1/2

36/ 3281-87 5 gw & S0ph PB 3292 500 A

S/ 10 bwph PB 3270 48/ 3246-54

3 bwph 24/ 3216-20 22 goph 10 hr.

1000 A S/ 16 boph Comp. 3350 P/ 16 boph

P/ 17 boph Comp. 312 bopd

Scout Cards *mm*  
Land Small Map .....  
Land Wall Map .....  
Tracings .....  
Fence Map .....  
Pierce Map .....  
Misc. ....

APR 15 1953

Orig. Data