


DX 78-1

Barton

Section 28 Township 19 Range 11W

Well No. #5 Thiel

Company Lewis Drlg.

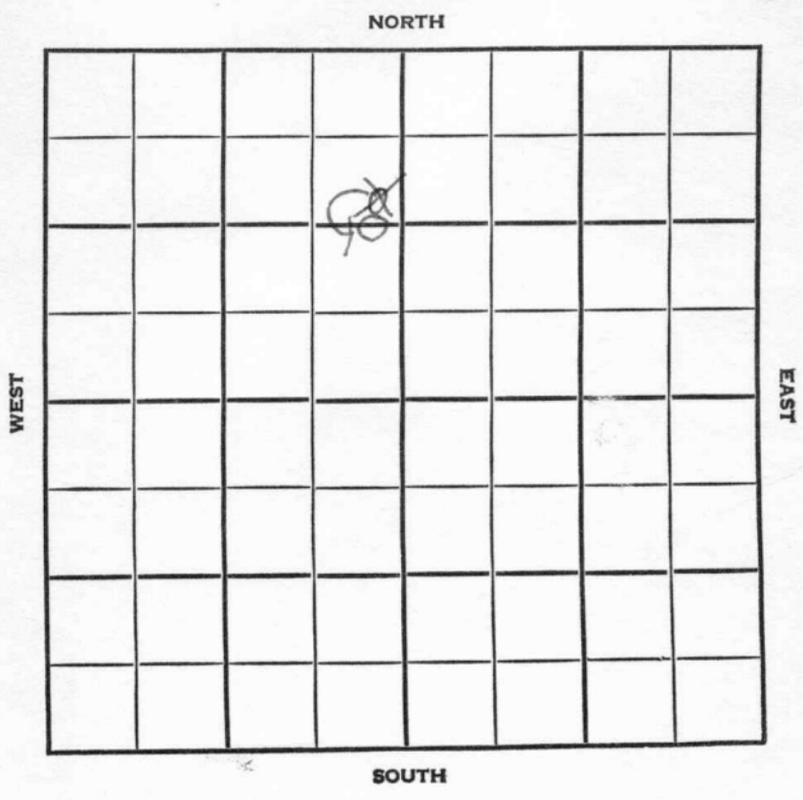

Barton

KANSAS


SEC. 28	TWP. 19	R. 11W
------------	------------	-----------

WELL NO. **5 Thill** FARM

COMPANY **Lewis Drlg.**

CONTRACTOR **Co. Tools
N. Ellinwood**

1320 Ft. from N. Line
 _____ Ft. from S. Line
330 Ft. from E. Line
 _____ Ft. from W. Line

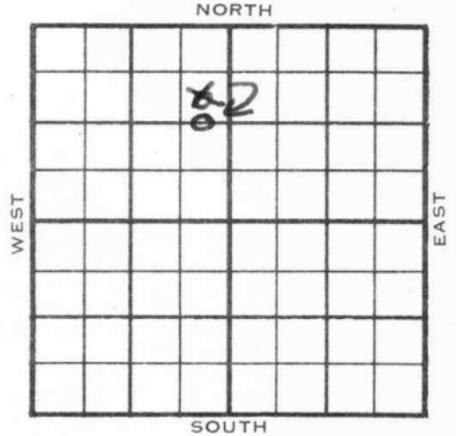

~~CE/2 E/2 NW~~
~~SE NE NW~~

1955	ELEVATION	REPORT
------	-----------	--------

6/15 Comm 6-13-55
 8" @ 227/185
 Drlg 500

7/7 DST 3062-70 open 1/2 hr. Rec 10' mud Off
 DST 3073-83 open 1 hr. Rec. 690' sw 870
 # DST 3130-37 open 1 hr. Rec. 150' o &
 gcsw DST 3195-3208 open 1 hr. Rec 12' m
 mud Off DST 3342-52 open 1/2 hr. Tool plug
 -ged D&A.

Tops:	Depth	Datum
Tp.	2662	877
H.	2924	1139
BL.	303041	1256
L.	3060	1275
A.	3339	1554
TD.	3372	

ABANDONED

SCOUT TICKET

DX-201

~~Kansas~~

SEC.

TWP.

R.

28

19

11W

WELL NO.

5 Thill

FARM

COMPANY

Lewis Drlg.

CONTRACTOR

CORRECTION


C $E\frac{1}{2}$ $E\frac{1}{2}$ NW

1320 FT. FROM N. LINE

_____ FT. FROM S. LINE

330 FT. FORM E. LINE

_____ FT. FROM W. LINE

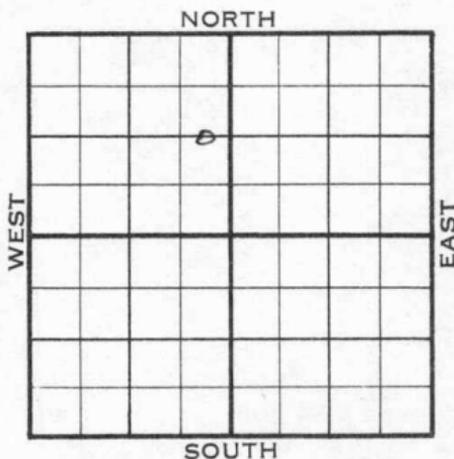

Barton County

LOCATION

RIG UP

DRILLING AND REMARKS:

Reported
SE NE NW

RECORD

CASED IN., FT.

SAND

GAS

OIL

TOTAL DEPTH

PRODUCTION

1ST 24 HRS. NAT.

1ST 24 HRS. AFTER SHOT

GAS CU. FT.

DRY HOLE

ABANDONED

DATE

SCOUT

JUN 22 1955

L. J. Harris

County Barton Elev. _____
 Sec. 28 Twp. 19 Rge. 11W
 Company Lewis Drlg.
 Farm Name Thill No. 5

TOPS	DEPTH	LOG	DATUM
Anh.			
T.p.			
H.			
Tr.			
Dg.			
Bl.			
L.			
K.C.			
B.K.C.			
Ce.			
C.			
M.			
M.			
K.			
Mz.			
Me.			
V.			
S.			
S.			
A			
R.			
Pe.			
G.			
T.D.			

Loc. in Sec. _____
SE NE NW
EZEZ
 Geol. _____
 Contr. _____
Co. tools
 Pool _____
N. Ellinwood

0
 JUN 15 '55
 FIRST REPORT

Date Comm. 6-13-55
8" @ 227/385 drlg. 500

Co.
 Lse.
 No.
 Sec.
 T.
 R.

County Barton Elev. 1782 DF
1785 RB
 Sec. 28 Twp. 19 Rge. 11W
 Company Lewis Drlg.
 Farm Name Thill No. 5

TOPS	DEPTH	LOG	DATUM
Anh.			
Tp.	<u>2662</u>		<u>877</u>
H.	<u>2924</u>		<u>1139</u>
Tr.			
Dg.			
BL.	<u>3041</u>		<u>1256</u>
L.	<u>3060</u>		<u>1275</u>
K.C.			
B.K.C.			
Ce.			
C.			
M.			
M.			
K.			
Mz.			
Mo.			
V.			
S.			
S.			
A	<u>3339</u>		<u>1537</u>
R.			
PE.			
G.			
TR.	<u>3372</u>		

Loc. in Sec. C E $\frac{1}{2}$ E $\frac{1}{2}$ NW
 Geol. _____
 Contr. _____
 Co. tools _____
 Pool _____
N. Ellinwood



Date Comm. 6-13-55 JUL 6 1955

8" @ 227/185 DST 3062-70 open $\frac{1}{2}$ hr.
Rec. 10' mud 0# DST 3073-83 open
1 hr. Rec. 690' sw 870# DST 3130-37
open 1 hr. Rec. 150' o & gcsw
DST 3195-3208 open 1 hr. Rec. 12' mud
0#DST 3342-52 open $\frac{1}{2}$ hr. tool plugged

D & A

Co.
 Lse.
 No.
 Sec.
 T.
 R.