

KANSAS

Barton


FORM 51 IOM 12-46 PETROL

Section 28 Township 19 Range 11-W

Well No. 1 Thill "A"

Company C. E. Ash

Ellinwood Pool NORTH

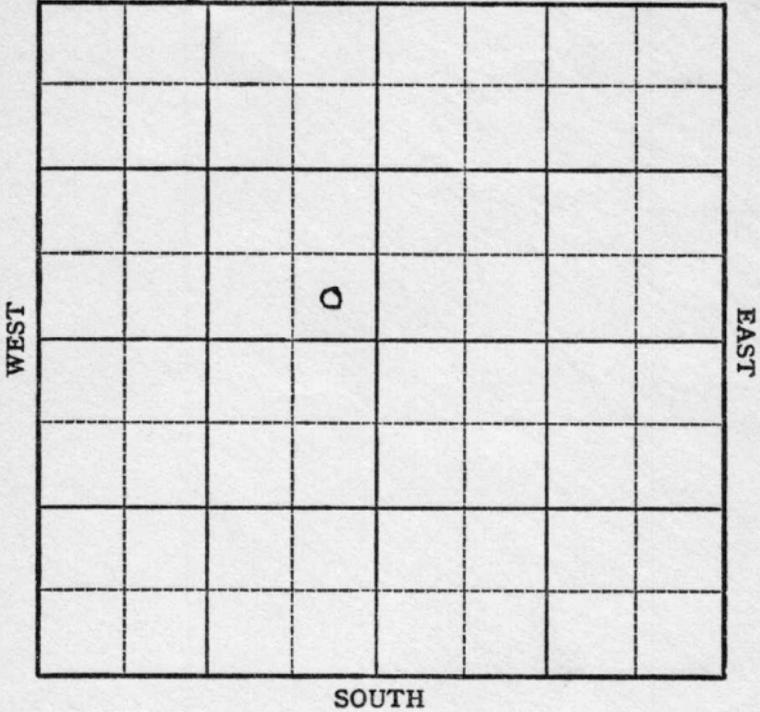

Sec. 28 Twp. 19 R. 11W

Well No. #1 Thill "A" Farm

C. E. Ash Company
Ellinwood


 Ft. from N. Line

330 Ft. from S. Line

330 Ft. from E. Line

 Ft. from W. Line

SE NW

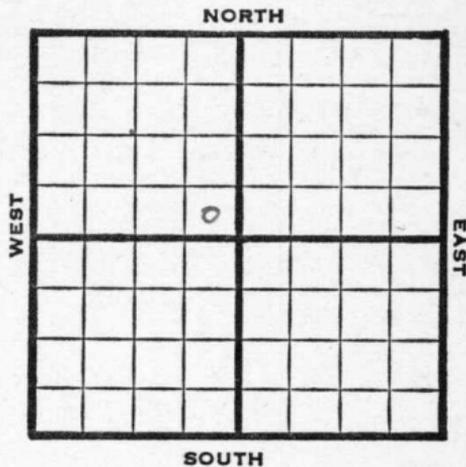

1947

Elev. 1781' REPORT

9/24

RUR

10/1

8" @ 217'
Drlg. 2125'

10/8

Lansing 3059
Cong 3326'
TD 3383 in Cong.

ABANDONED

Map No. _____ Sec. 28 Twp. 19 R. 11W

Well No. 1 Thill "A"

C. E. Ash Company

FIRST REPORT

Contractor

SE NW

SECTION PLAT

_____ Ft. from N. Line

330 Ft. from S. Line

330 Ft. from E. Line

_____ Ft. from W. Line

Barton County

Location _____

Rig up _____

Drilling and Remarks:

R U R

RECORD

Cased _____ in., _____ ft.

Sand _____

Gas _____

Oil _____

Total Depth _____

PRODUCTION

1st 24 hrs. Nat. _____

1st 24 hrs. after shot _____

Gas _____ Cu. Ft.

Dry Hole _____

Abandoned _____

Date

SEP 24 1947 19

S. J. LEWIS Scout

Form 26 200 Bks. 10-46 Petrol
Kansas

Map No. 46 Sec. 28 Twp. 19 R. 11W

Well No. 1 Thill "A"

C. E. Ash Company

ABANDONED

Contractor

SE NW

E 1177
SECTION PLAT

_____ Ft. from N. Line

330 Ft. from S. Line

330 Ft. from E. Line

_____ Ft. from W. Line

Barton County

Location _____

Rig up _____

Drilling and Remarks:

Lease 8059
Comp 3326.

RECORD

Cased _____ in., _____ ft.

Sand _____

Gas _____

Oil _____

Total Depth 3383 in Comp

PRODUCTION

1st 24 hrs. Nat. _____

1st 24 hrs. after shot _____

Gas _____ Cu. Ft.

Dry Hole _____

Abandoned _____

Date

OCT 8 1947 19

S. J. LEWIS Scout