


Section 28 Township 19 Range 11W

Well No. #2 Hartman

Company Alpine Oil & Royalty

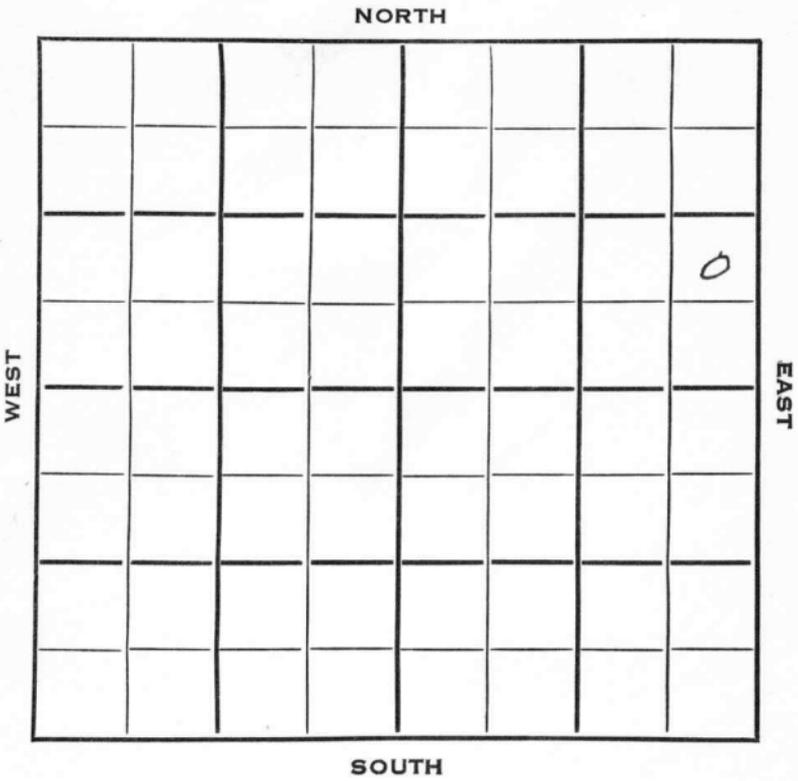

Sec. 28 Twp. 19 R. 11 W

Well No. # 2 Hartman Farm

Alpine Oil & Royalty Company

Quaker Drlg. Contractor


Anton Pool

_____ Ft. from N. Line

990 Ft. from S. Line

330 Ft. from E. Line

_____ Ft. from W. Line

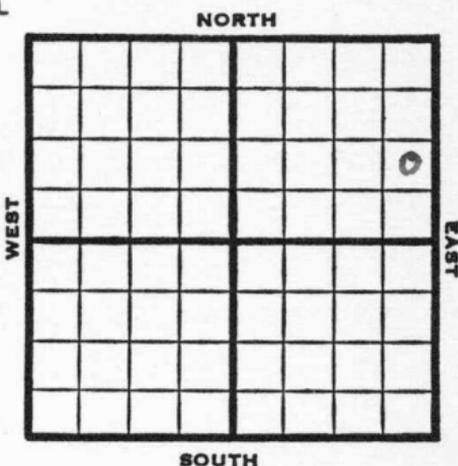

NE SE NE

1953

Elev. 1779' REPORT

3/11

Spud 3-7-53
8" @ 237

Drlg. 1145'

3/19

Heeb 2911' Br li 3031' Lans 3050'
DST 3068-80', 1/2 hr, 390' fluid,
mostly oil.

3/26

NR

4/2

"

4/8

Spud 3-7-53 Oil well TD 3351
8" @ 237 Heeb 2911 Br lime 3031
Lans. 3050
DST 3068-80 open 1/2 hr. rec 390' fluid
(mostly oil)
DST 3100-20, open 1/4 hr. rec 840' oil
60' mud 1000#
DST 3180-99 open 3/4 hr. rec 4' mud Off
DST 3206-17 open 1 hr. rec 35' mud Off
Cong. 3324 Arb. 3338' TD 3347
5" @ 3343 DD 3351 S/1 1/4 BOPH 500 A
Comp. 25 BOPD

COMPLETED

County Barton State Kansas

Sec. 28 (Blk. Twp.) 19 (Sur. Rge.) 11W Map No.

Operator Alpine Oil & Royalty

Well No. 2 Farm Hartman

Elev. _____ Location NE SE NE

					0

990 Ft. From S Line NE

330 Ft. From E Line Quarter

1st. Report MAR 11 1950

Completion _____

Remarks _____

Quaker Drlg. - Contr.

Spudding Date 8-7-53

Drlg. Data Anton Pool

8" @ 237 drlg. 1145

