


Section 28 Township 19 Range 11 W

Well No. # 3 Hartman

Company Alpine Oil & Royalty

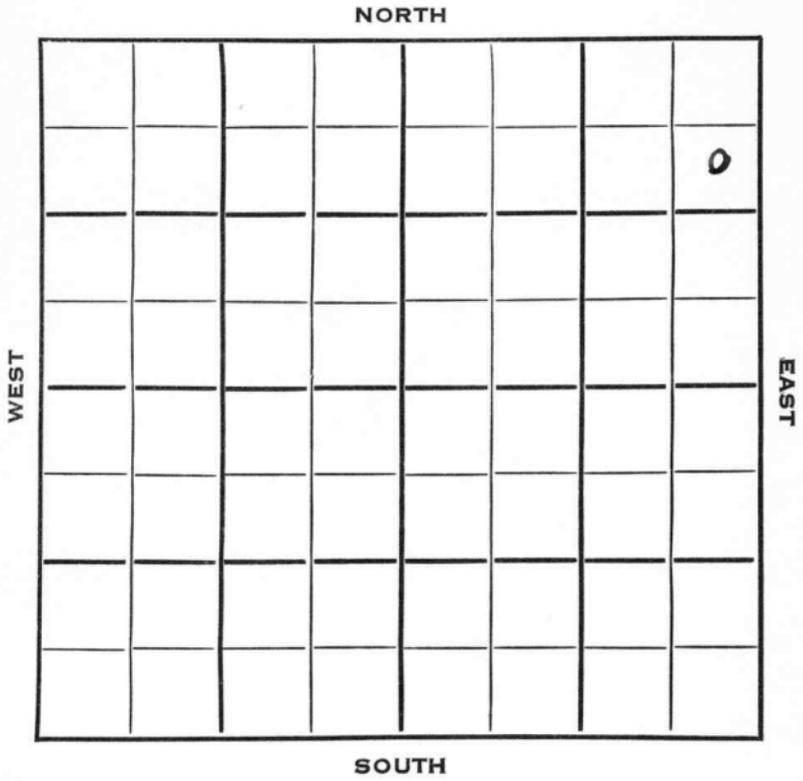

Sec. 28 Twp. 19 R. 11W

Well No. #3 Hartman Farm

Alpine Oil & Royalty Company

Quaker Drlg. Contractor

Anton Pool


990 Ft. from N. Line

_____ Ft. from S. Line

330 Ft. from E. Line

_____ Ft. from W. Line

SE NE NE

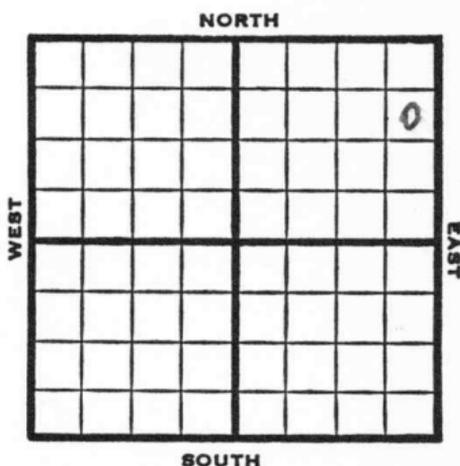

1953

Elev. 1779' REPORT

4/15

RUR

4/23

8" @ 230
Drlg. 2800'

4/30

Arb. 3342 RTD 3346 5" @ 3345

5/7

DD 3367 TD w. PB 3140
48/ 3113-21 S/ 25 Bopd.

5/21

NR

5/28

"

6/3

NR

6/10

Spud 4-14-53
Oil Well
TD 3367'
8" @ 230'
Heeb 2909, Br. Lime 3025, Lans 3045,
DST 3058-3119 opn 1/4 hr, rec 750' ocm
Arb 3342,
TD 3346
5" @ 3345'
DD 3367 wtr. PB 3140
48/ 3113-21 S/ 25 bopd
Comp 25 bopd.

COMPLETED

