


Section 28 Township 19 Range 11 W

Well No. # 4 Hartman

Company Alpine Oil & Royalty

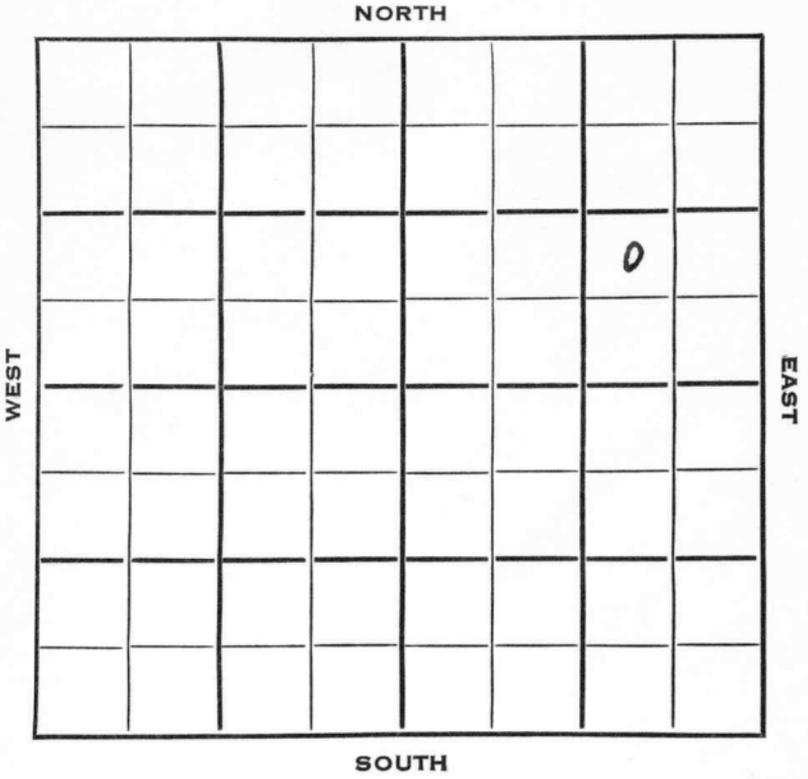

Sec. 28 Twp. 19 R. 11W

Well No. #4 Hartman Farm

Alpine Oil & Royalty Company

Alpine O&R Contractor  
Anton Pool


         Ft. from N. Line

990 Ft. from S. Line

880 Ft. from E. Line

         Ft. from W. Line

NW SE NE

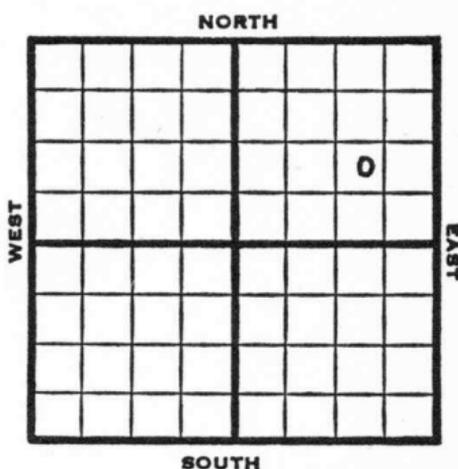

1953 Elev. 1779' REPORT

5/13 Spud 5-7-53  
 8" @ 205'  
 Drlg. 2088'

5/21 NR

5/28 Heeb 2913, Br L. 3031, Lans 3051  
 RT<sup>D</sup> 3365  
 5" @ 3364

6/3 NR

7/1 "

7/8 42/3115-22, POP

7/22 NR

7/29 "

8/12 "

8/19 Spud 5-7-53  
 Oil Well  
 TD 3365'  
 8" @ 205'  
 Heeb 2913, Br. Lime 3031, Lans 3051,  
 TD 3365'  
 5" @ 3364'  
 DST 3064-3121 gas in 6 min, opn 7 min  
 rec 480' o & gcm 1082# Cong 3322  
 42/ 3115-22  
 Comp. 25 bopd.

COMPLETED



