


Section 28 Township 19 Range 11 W

Well No. # 5 Hartman

Company Alpine Oil & Royalty

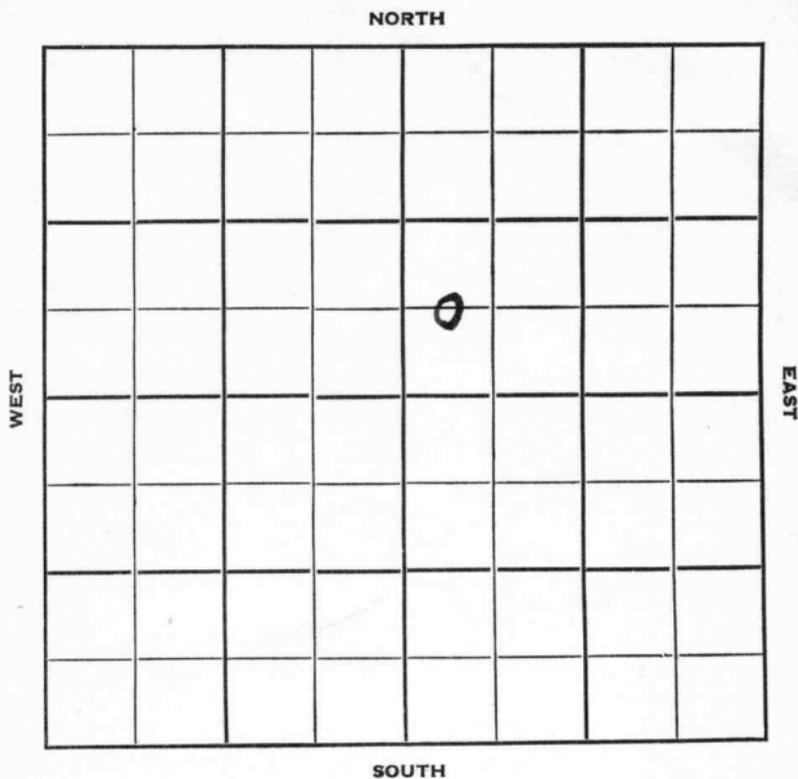

Barton KANSAS



Sec. 28 Twp. 19 R. 11 W

Well No. # 5 Hartman Farm

Alpine Oil & Royalty Company

Quaker Drlg. Contractor

Anton Pool


Ft. from N. Line

660 Ft. from S. Line

Ft. from E. Line

330 Ft. from W. Line

C W L SW NE

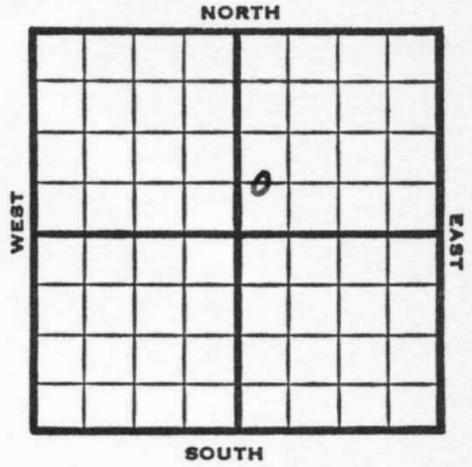

1953 Elev. 1780' REPORT

6/17 Location
 6/21 RUR
 7/1 8" @ 235'
 Heeb 2919, Br. L. 3036, Lans 3056,
 Arb 3329
 RTD 3334'
 5" @ 3331'

7/8 CO
 7/22 "

7/29 "
 8/12 NR

8/19 Spud 6-15-53
 Oil Well
 TD 3362'
 8" @ 235'
 Heeb 2919, Br. Lime 3036, Lans 3056,
 Arb 3329,
 TD 3334'
 5" @ 3331'
 DD 3349 DD 3362 5 go 20 gwph SP
 3160 24/ 3122-30 FU 2200' oil 12
 hr.
 Comp. 25 bopd.

COMPLETED

