

Barton

KANSAS

Section 28 Township 19 Range 11 WWell No. # 6 HartmanCompany Alpine Oil & Royalty

NORTH

				0			

SOUTH

WEST


EAST

KANSAS ✓

Barton

Sec. 28 Twp. 19 R. 11WWell No. #6 Hartman FarmAlpine Oil & Loyalty CompanyQuaker Drlg. Contractor
Anton Pool Ft. from N. Line330 Ft. from S. Line Ft. from E. Line330 Ft. from W. Line

SW SW NE

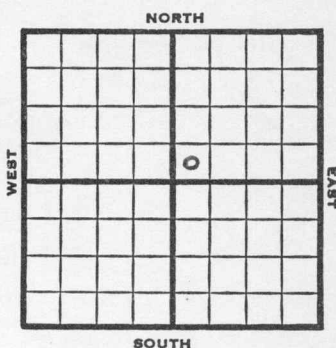

1953 Elev. 1780' REPORT

7/1 Spud 6-22-53
8" @ 225'
Drlg. 2929'

7/8 Heeb 2923, Br li 3035, Lans 3056, Cong 3332
RTD 3354
5" @ 3351

8/19 Spud 6-22-53
Oil Well
TD 3354'
8" @ 225'
Heeb 2923, Br. Lime 3035, Lans 3056, Cong 3332,
TD 3354'
5" @ 3351'
18/ 3124-30
Comp. 25 bopd.

COMPLETED

J. G. McGEHEE