

O.W.W.O.

KANSAS

Barton

Section 28 Township 19 Range 11-W


Well No. #1 Hartman

Company Alpine Oil & Royalty

NORTH

WEST

EAST

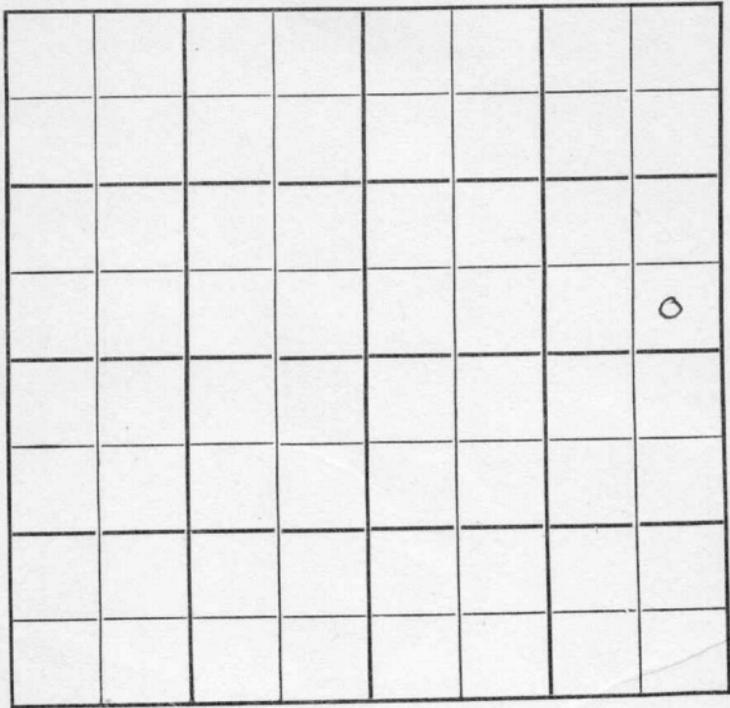

SOUTH

Sec. 28 Twp. 19 R. 11-W

Well No. #1 Hartman Farm

Alpine Oil & Royalty Company

Quaker Drlg. Contractor


Wildcat Anton

_____ Ft. from N. Line

330 Ft. from S. Line

330 Ft. from E. Line

_____ Ft. from W. Line

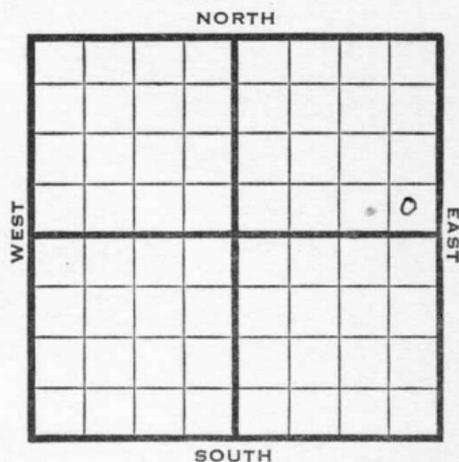

SE SE NE

Oil Well

1950 Elev 1779 REPORT

7/19 Spud 7-13-50
8" @ 250
Anhy 550
Drlg 2696

9/13 8" @ 250
Anhy 550 Heeb 2926
Br lime 3036 Lans 3056
Cong 3316 Arb 3340-45
4 1/2" @ 3342
TD 3350
500 A FU 2000' oil S/4 boph
Comp 30 bopd 50% water
Completed

COMPLETED

O.W.W.O.

1953
9/30 Heeb 2926', Br. lime 3036', Lans
3056, Cong 3316', Arb. 3340'
TD 3345'
5" @ 3345
To perf KC

10/7 Oil well TD 3345' Heeb 2926
Br lime 3036 Lans 3056 Cong 3316
Arb. 3340 TD 3345 5" @ 3345
Abd. operation Did not work over.

ABANDONED

Kansas

Wildcat

Map No. _____ Sec. 28 Twp. 19 R. 11W

Well No. 1 Hartman

Alpine Oil & Royalty Company

Quanker Drlg. Contractor

SE SE NE

SECTION PLAT



_____ Ft. from N. Line

330 Ft. from S. Line

330 Ft. from E. Line

_____ Ft. from W. Line

Barton County

Location _____

Rig up _____

Drilling and Remarks:

Spud 7-13-50

8" @ 250

Anhy 550

drlg. 2696

RECORD

Cased _____ in., _____ ft.

Sand _____

Gas _____

Oil _____

Total Depth _____

PRODUCTION

1st 24 hrs. Nat. _____

1st 24 hrs. after shot _____

Gas _____ Cu. Ft.

Dry Hole _____

Abandoned _____

Date

JUL 19 1950

J. E. TYRA

19

Scout


County Barton State Kansas

Sec. 28 (Blk. 19) (Sur. 11W) (Twp.) (Rge.) Map No.

Operator Alpine Oil & Royalty

Well No. 1 Farm Hartman

Elev. 1779 Location SE SE NE

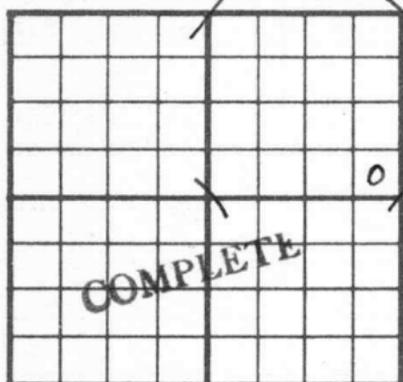

330 Ft. From S Line NE

330 Ft. From E Line Quarter

1st. Report

Completion SEP 13 1950

Remarks

Anton Pool

Spudding Date 7-13-50

Drlg. Data Oil well TD 3350

8" @ 250 Anhy 550 Heeb. 2926

Br. lime 3036 Lans. 3056 Cong. 3316

Arb. 3340-45 4 1/2" @ 3342 TD 3350

500 A FU 2000' oil S/ 4 boph

Comp. 30 bopd 50% water

O.W.W.O.

County Barton State Kansas

Sec. 28 (^{Blk.}19) (^{Sur.}11W) Map No.

Operator Alpine Oil & Royalty

Well No. 1 Farm Hartman

Elev. 1779 Location SE SE NE

330 Ft. From S Line NE

330 Ft. From E Line Quarter

1st. Report SEP 30 1953

Completion _____

Remarks O.W.W.O.

O.W.W.O.

Spudding Date _____

Drlg. Data Anton Pool

~~Heeb. 1779~~ Heeb. 2926 Br. line 3036

Lans. 3056 Cong. 3316 Arb. 3340

TD 3345 5" @ 3345 to perf. KC

