


Section 28 Township 19 Range 11 W

Well No. # 1 Schwanboi (Schwanborn)

Company Alpine Oil & Royalty

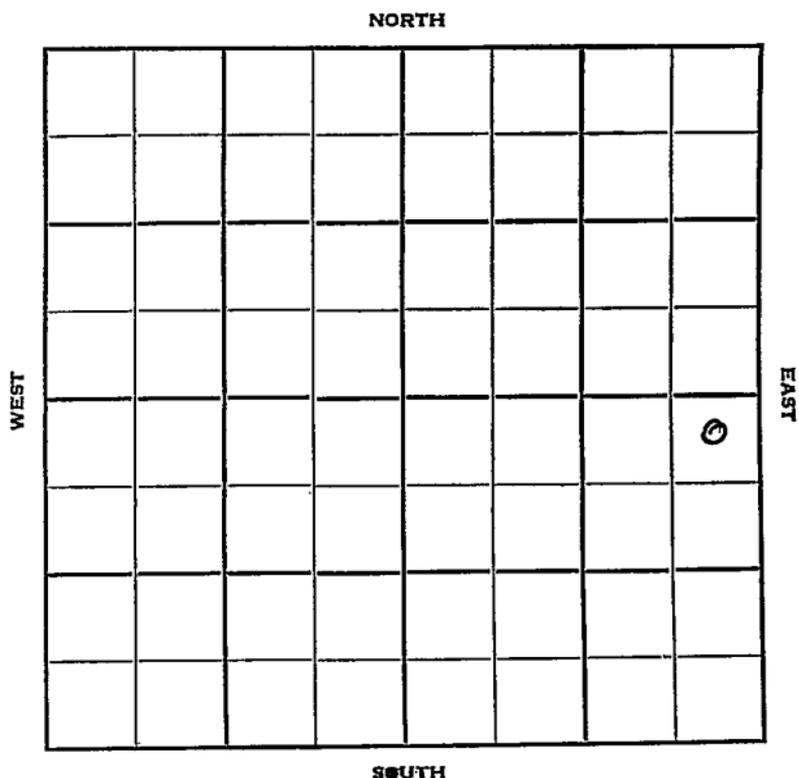

Sec. 28 Twp. 19 R. 11W ✓

Well No. #1 Schwanboi Farm

Alpine Oil & Royalty Company

Quaker Drlg. - Contr. Contractor


330' Ft. from N. Line

\_\_\_\_\_ Ft. from S. Line

330' Ft. from E. Line

\_\_\_\_\_ Ft. from W. Line

NE NE SE

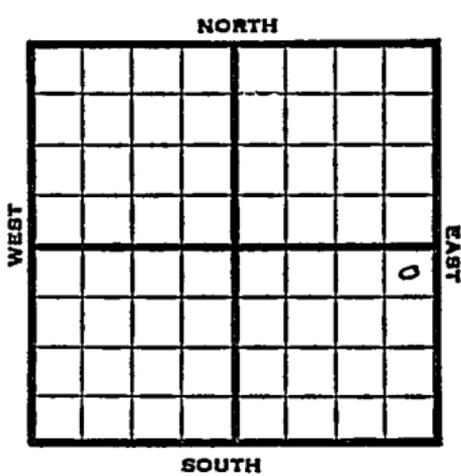

1951 Elev. 1779' REPORT

2/14 Cellar & Pits  
 3/14 Spud 2-17-51  
 D & A TD 3362  
 8" @ 250  
 Heeb 2931, Br. lime 3050, Lans 3071,  
 Cong. 3332, Arb. 3347-51  
 5" @ 3348  
 TD 3362 FU 500' water D & A  
**ABANDONED**

County Barton State Kansas

Sec. 28 (Blk. 19) (Sur. 11W) (Twp.) (Rge.) Map No.

Operator Alpine Oil & Royalty

Well No. I Farm Schwanboi

Elev. \_\_\_\_\_ Location NE NE SE

FIRST REPORT					
					0

330 Ft. From N Line SE

330 Ft. From E Line Quarter

1st. Report FEB 14 1951

Completion \_\_\_\_\_

Remarks \_\_\_\_\_

Quaker Drlg. - Contr.

Spudding Date \_\_\_\_\_

Drlg. Data \_\_\_\_\_

Cellar & pits

