

Barton  
19

KANSAS  
11W


28

Section \_\_\_\_\_ Township \_\_\_\_\_ Range \_\_\_\_\_

Well No. #1 Schwanborn \_\_\_\_\_

Company Petroleum, Inc. \_\_\_\_\_

NORTH

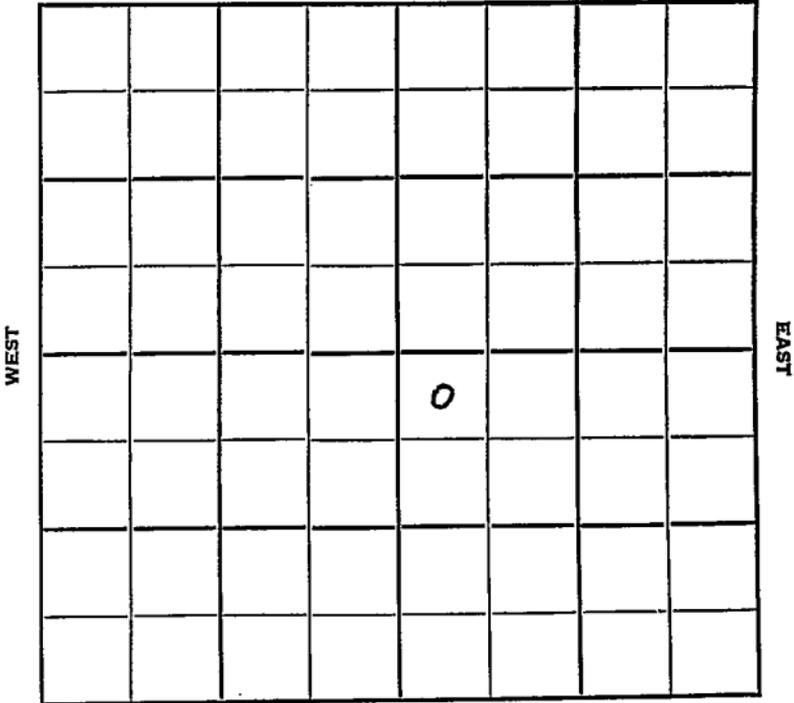

SOUTH

Sec. 28 Twp. 19 R. 11W

Well No. #1 Schuette Farm

Petroleum Inc. Company

Garvie Contractor

**Thill Pool**


330 Ft. from N. Line

\_\_\_\_\_ Ft. from S. Line

\_\_\_\_\_ Ft. from E. Line

330 Ft. from W. Line

NW NW SE

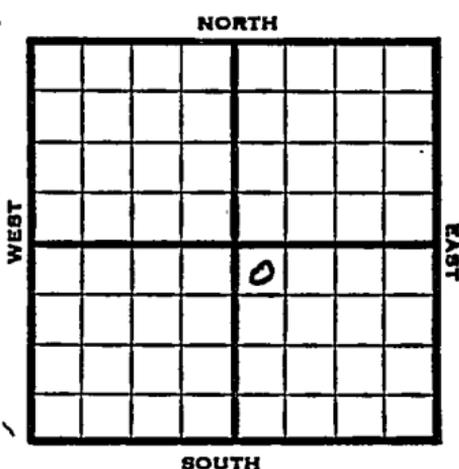

1953

REPORT

Elev. 1778'

275/27

Spud 5-21-53  
8" @ 176'  
Drlg 2756'

6/3

Heeb 2917, Br li 3036, <sup>L</sup>ans 3056  
DST 3057-84, 1 hrs., 35' gcm  
DST 3114-30, 1/4 hrs., F oil in  
9", 3130' oil, 780#  
DST 3185-3210, 1/2 hrs., 5' M  
DST 3221-67, 3/4 hrs., 35' M  
705#  
Cong 3326  
RTD 3365  
5" @ 3225

6/10

C.O.

6/21

17/3124-30 F 12 BOPH 12 hr.s

7/1

Spud 5-21-53 Oil well TD 3365  
8" @ 176' Heeb 2917 Br lime 3036  
Lans 3056  
DST 3057-84 open 1 hr rec 35' GCM O#  
DST 3114-30 open 1/4 hr F/oil 9 min  
Rec 3130' oil 780#  
DST 3185-3210 open 1/2 hr rec 5' mud O#  
DST 3221-67 open 3/4 hr. rec 35' mud  
705# Cong. 3326 TD 3365  
5" @ 3225 GO to 3365 17/3124-30  
F/12 BOPH 1000 A  
Comp. 3000 BOPD

**COMPLETED**



County Barton State Kansas  
 Sec. 28 (Blk. 19) (Sur. 11W) (Twp.) (Rge.) Map No.  
 Operator Petroleum Inc.  
 Well No. 1 Farm Schwanborn  
 Elev. 1778 Location NW NW SE


COMPLETE

330 Ft. From N Line SE  
330 Ft. From W Line Quarter  
 1st. Report \_\_\_\_\_  
 Completion JUL 1 1953  
 Remarks Thill Pool  
Garvie - Contr.  
 Spudding Date 5-21-53

Drlg. Data Oil well TD 3365  
8" @ 176 Heeb. 2917 Br. lime 3036  
Lans. 3056 DST 3057-84 open 1 hr.  
Rec. 35' gcm 0# DST 3114-30 open 1/4 hr.  
R/coil 9 min. Rec. 3130' oil 780#  
DST 3185-3210 open 1/2 hr. Rec. 5' mud  
0# DST 3221-67 open 3/4 hr. Rec.  
35' mud 705# Cong. 3326 TD 3365  
5" @ 3225 CO to 3365 17/ 3124-30  
F/ 12 boph 1000 A  
Comp. 3000 bopd