


Section 28 Township 19 Range 11W

Well No. #7 Hartman

Company Alpine Oil & Royalty

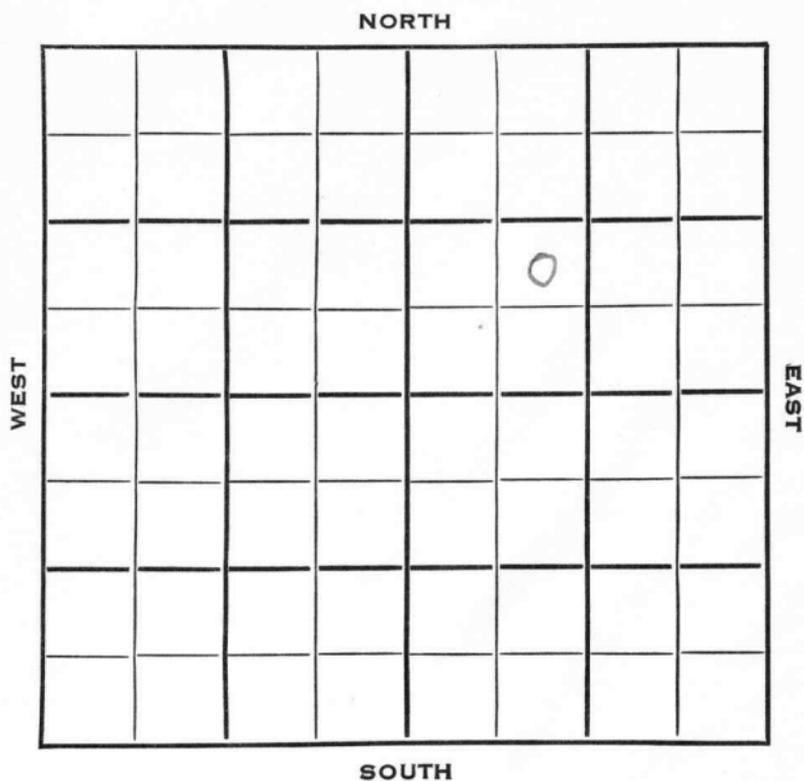

SEC.	TWP.	R.
28	19	11W

WELL NO. #7 Hartman FARM

COMPANY Alpine Oil & Royalty

CONTRACTOR

Quaker Drlg.


Anton Pool

Ft. from N. Line

990 Ft. from S. Line

1560 Ft. from E. Line

Ft. from W. Line

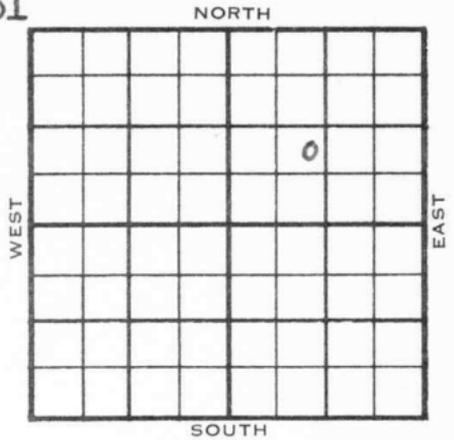

NE SW NE

	ELEVATION	REPORT
1953	1779'	

11/4 Spud 10-29-53
8" @ 215'
Drlg 2207'

11/11 Arb. 3344'
RTD 3350'
5" @ 3347'

11/18 NR
12/9 "

1954
1/6 NR
1/13 NR

2/17 Spud 10-29-53
Oil Well
TD 3350'
8" @ 215'
Lans 3055', Arb. 3344
TD 3350'
5" @ 3347'
Heeb 2916', Br lime 3035', Cong 3321'
2 DST's
S/2 boph
PB 3299, perf 3126-29
Comp. 316 bopd

COMPLETED

County Barton State Kansas

Sec. 28 (Blk. 19) (Sur. 11W) (Twp.) (Rge.) Map No.

Operator Alpine Oil & Royalty

Well No. 7 Farm Hartman

Elev. Location NW SW NE

		X	0	

990 Ft. From S Line NE

¹⁵⁶⁰
330 Ft. From W Line Quarter

1st. Report NOV 4 1953

Completion

Remarks

Quaker Drlg. - Contr.

Spudding Date 10-29-53

Drlg. Data Anton Pool

8" @ 215 drlg. 2207

