

Section 28 Township 19 Range 12 W

Well No. # 1 Bryan

Company G-M-R Drlg.

10

NORTH

				0			

WEST

EAST

SOUTH

Sec. 28 Twp. 19 R. 12W

Well No. #1 Bryan Farm

G M R Drlg. Company

Contractor


330 Ft. from N. Line

Ft. from S. Line

Ft. from E. Line

330 Ft. from W. Line

NW NW SE

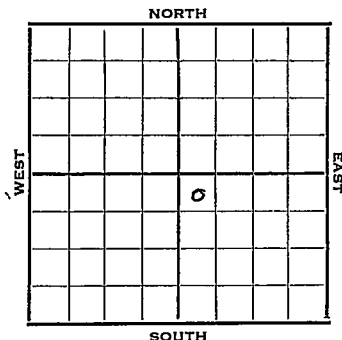

1952 Elev. 1818 REPORT

8/27 Location

9/3 8" @ 146
Anhy 635
Drlg. 2625

9/10 Spud 8-26-52
D&A TD 3440
8" @ 146 Anhy 635
Heeb. 2993 Br lime 3118
Lans. 3136
DST 3270-3315 opn 1 hr. Rec. 30' gem
O# Cong. 3380 Arb. 3414 TD 3440
D&A

ABANDONED

