


KANSAS Barton County

FORM 51 5M PETROL

Section 28 Township 19 Range 12W

Well No. 1 Johnson

Company Transwestern *12*

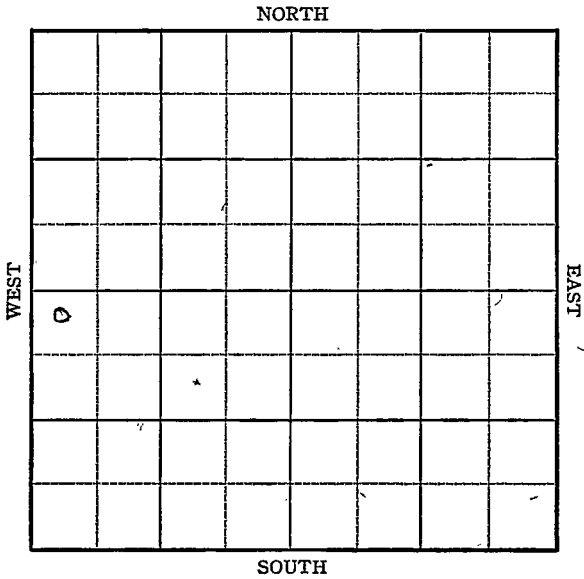

Sec. 28 Twp. 19 R. 12W

Well No. 1 Johnson Farm

Transwestern Company

Wildcat


330 Ft. from N. Line

Ft. from S. Line

Ft. from E. Line

330 Ft. from W. Line

NW SW Elev. 1819

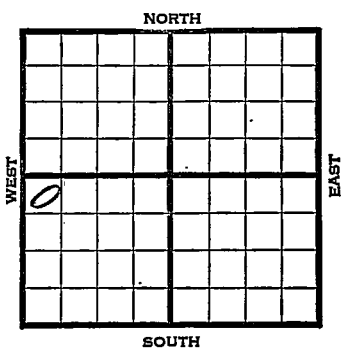

1945

REPORT

6/27	Location
7/3	RUR
7/11	8" @ 255 Anhy 610 Drlg. 1250'
7/19	Lans 3138 SO Drlg. 3250
7/26	Cong 3371 Arb. 3394 TD 3405 VSSO 5" @ 3397 RUST
8/15	Arb. 3392 5" @ 3392 TD 3436'

ABANDONED

Kansas Pool Name Wildcat

Map No. 46 Sec. 28 Twp. 19 R. 12W

Well No. 1 Johnson

Transwestern Company

FIRST REPORT

Contractor

NW SW

SECTION PLAT

330 Ft. from N. Line

_____ Ft. from S. Line

_____ Ft. from E. Line

330 Ft. from W. Line

o			

Barton County

Location X

Rig up _____

Drilling and Remarks:

RECORD

Cased _____ in., _____ ft.

Sand _____

Gas _____

Oil _____

Total Depth _____

PRODUCTION

1st 24 hrs. Nat. _____

1st 24 hrs. after shot _____

Gas _____ Cu. Ft.

Dry Hole _____

Abandoned _____

Date

JUN 27 1945 19

S. J. LEWIS Scout

KANSAS Kansas Pool Name Wildcat

Map No. 46 Sec. 28 Twp. 19 R. 12W

Well No. 1 Johnson

Transwestern Company

ABANDONED

Contractor

NW SW

E. 187
SECTION PLAT

330 Ft. from N. Line

_____ Ft. from S. Line

_____ Ft. from E. Line

330 Ft. from W. Line

<i>a</i>			

Barton County

Location _____

Rig up _____

Drilling and Remarks:

Per 3392
J" 3392

RECORD

Cased _____ in., _____ ft.

Sand _____

Gas _____

Oil _____

Total Depth: 3436.

PRODUCTION

1st 24 hrs. Nat. _____

1st 24 hrs. after shot _____

Gas _____ Cu. Ft.

Dry Hole _____

Abandoned _____

Date

AUG 15 1945 19

S. J. LEWIS Scout