


Barton

KANSAS

Section 28 Township 19 Range 12 W

Well No. # 1 Hammer

Company Petroleum Inc.

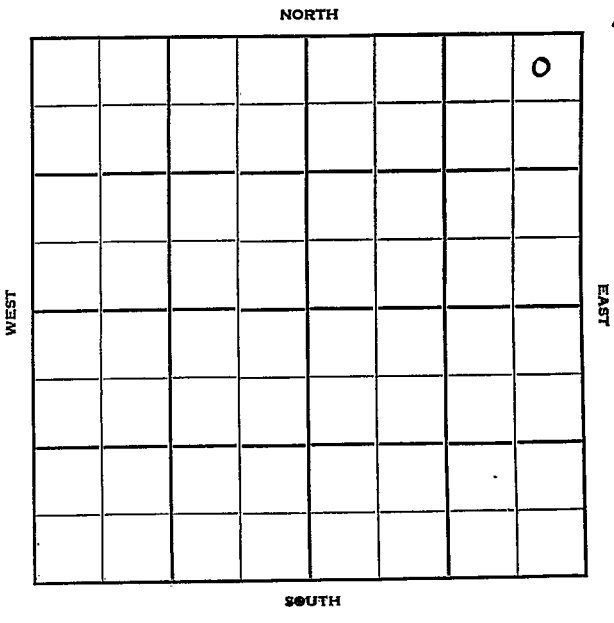

Sec. 28 Twp. 19 R. 12 W

Well No. # I Hammer Farm

Petroleum Inc. Company

Garvey Oil. Contractor

Dartmouth Pool


330 Ft. from N. Line

\_\_\_\_\_ Ft. from S. Line

330 Ft. from E. Line

\_\_\_\_\_ Ft. from W. Line

NE NE NE

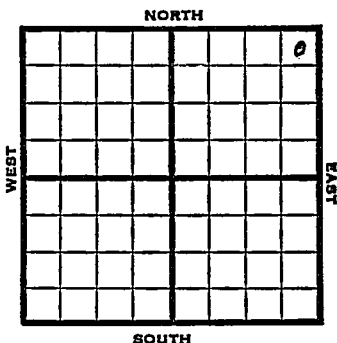

1951 Elev. 1839' REPORT

12/12 Spud 12-7-51  
8-5/8" @ 194  
Drlg 1804'

1952  
1/2 Spud 12-7-51 D & A TD 3465'  
8-5/8" @ 194' Heeb 3036' Br. lime  
3154' Lans. 3169'  
DST 3172-3200 open 1 hr, rec 38' mud  
DST 3294-3322 open 1 hr. rec 80' mud  
Cong. 3425' Arb. 3430'  
DST 3431-34 open 1 hr. rec 8' mud  
DST 3432-38 open 1 hr. rec 5' OCM  
DST 3437-45 open 1 1/2 hr. rec 10' mud  
DST 3433-55 open 1/2 hr. rec 12' mud  
DST 3455-65 open 45 min. rec 28' WCM  
TD 3465' D & A

**ABANDONED**



