

Section 28 Township 19 Range 12W

Well No. #2 H. Bryant

Company Texas

15

NORTH

WEST

EAST

SOUTH

Sec. 28 Twp. 19 R. 12W

Well No. #2 H. Bryant Farm

Texas Company

Braden Contractor

Darhmouth
Ft. from N. Line

990


Ft. from S. Line

Ft. from E. Line

330

Ft. from W. Line

NW SW SE

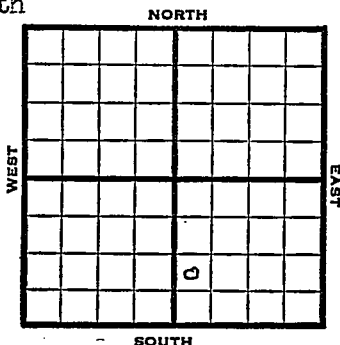

1952 Elev. 1817' REPORT

2/27 Spud 2-23-52
Drlg. 620'

3/5 8" @ 628
Heeb. 2974 Br Li 3093
Lans. 3112 To DST 3161

3/11 DST 3144-74, 1 hr. 30' SGCM
DST 3206-19, 1 hr. 30' m
DST 3248-78, 1 hr. 20' m & trace oil
80# Arb. 3383
DST 3355-3410, 1½ hr. 3' oil 30' SW
120' m 0# RTD 3410 5" @ 3410 WOC

3/19 DP to 3398 16/ 3388-92 NS
20/ 3191-96 S/ 1 gal oily mud

4/2 Spud 2-23-52
D&A TD 3410
8" @ 628' Heeb. 2974
Br Li 3093 Lans. 3112
DST 3144-74 open 1 hr. rec. 30' SGCM
DST 3206-19 open 1 hr. rec. 30' mud
DST 3248-78 open 1 hr. rec. 20' mud
tr. oil Arb. 3383
DST 3355-3410 open 1½ hr. rec. 3' oil
30' SW 120' mud TD 3410
5" @ 3410 DP to 3398
16/ 3388-92 20/ 3191-96

OVER

1952

4/2 S/ 1 go & mud Hydro. S/ 4 $\frac{1}{2}$ bo tr.
wtr. 10 hr. 36/ 3325-34 500 A
S/ 25 gwph SP 3278 20/ 3259-64
500 A S/ 25 go 37 gwph SP
3238 -24/ 3218-24 500 A S/ 8 bo
30bw 10 r. DP 3275 S/ 1 bo
22 bw 4 hr. PB 3197 32/ 3170-78
50 O A S/ 1 go 2 gwph 16/ 3148-52
300 A S/ 3GO ~~2gwph~~ 64 gw
7 hr. D&A

ABANDONED

Scout Cards *W*

Land Small Map.....

Land Wall Map..... *W*

Tracings.....


France Map

Pierce Map

Misc.....

FEB 29 1952

County Barton State Kansas
 Sec. 28 (Blk. 19) (Sur. 12W) (Twp.) (Rgs.) Map No.
 Operator Texas Company
 Well No. 2 Farm H. Bryant
 Elev. 1817 Location NW SW SE

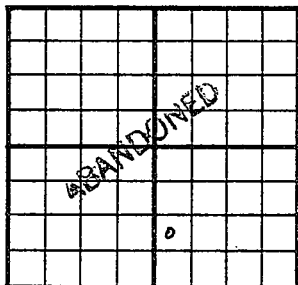

990 Ft. From S Line SE

330 Ft. From W Line Quarter

1st. Report

Completion APR 2 1952

Remarks Dartmouth Pool

Braden - Contr.

Spudding Date 2-23-52

Drig. Data D & A TD 3410

8" @ 628 Heeb. 2974 Br. lime 3093

Lans. 3112 DST 3144-74 open 1 hr.

Rec. 30' sgcm DST 3206-19 open 1 hr.

Rec. 30' mud DST 3248-78 open 1 hr.

Rec. 20' mud tr. oil Arb. 3383

DST 3355-3410 open 1½ hr. Rec. 3' oil

30' sw 120' mud TD 3410 5" @ 3410

DP to 3398 16/ 3388-92 20/ 3191-96

S/ 1 go & mud Hydro. S/ 4½ bo tr. water

10 hr. 36/ 3325-34 500 A S/ 25 bwph

16/ 3298-3302 500 A S/ 1 go 40 gwph

SP 3278 20/ 3259-64 500 A

S/ 25 go 37 gwph SP 3238 24/ 3218-24

J. G. McGEHEE

Orig. Data

500 A S / 8 bo 30 bw 10 hr. DP 3275

S / 1 bo 22 bw 4 hr. PB 3197 32 / 3170-78

500 A S / 1 fo 2 ewph 16 / 3148-52

3000 A S / 3 fo 64 ew 7 hr.

D & A

APR 8 1952

Scout Cards
Land Small Map
Land Wall Map
Tracings
France Map
Pierce Map
Misc.