


Section 28 Township 19 Range 12 W

Well No. # 2 Johnson (B)

Company B & R Drlg.

*3*

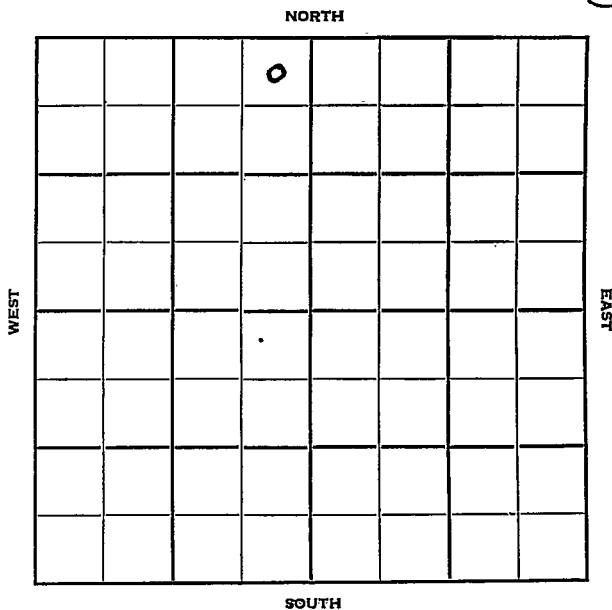

Sec. 28 Twp. 19 R. 12 W

Well No. # 2 Johnson (B) Farm

B & R Drlg. Company

B & R Drlg. Contractor


330 Ft. from N. Line

Ft. from S. Line

330 Ft. from E. Line

Ft. from W. Line

NE NE NW

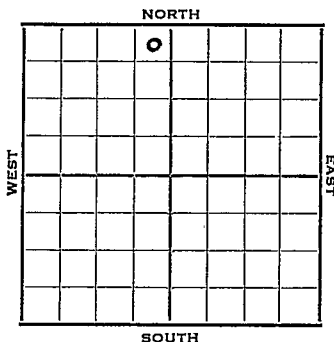

1952 Elev. 1882' REPORT

3/26 Spud 3-22-52  
8" @ 148'  
Drilling 650'

4/1 Anhy 715'  
Drlg. 2386'

4/9 Heeb. 3067 Lans. 3200  
DST 3252-82 1 hr. 30 M  
O# DST 3327-42 1 hr. 15 mins  
280 HGC Oil  
DST 3344-65 1 hr. 55' muddy SW  
680# TD 3484 5" @ 3393 1/2 WOCT

4/23 "

4/30 WOCT

5/7 CO 3355' 24/3336-42 4000 A  
S/400 BO 10 hrs. POP

5/14 NR

5/21 NR

5/28 "

6/11 Spud 3-22-52  
Oil Well TD 3484 8" @ 148'  
Anhy 715 Heeb. 3067  
Lans. 3200  
DST 3252-82 open 1 hr. rec. 30' mid  
DST 3327-42 open 1 1/4 hr. rec. 280'  
hgcol DST 3344-65 open 1 hr. rec.  
55' muddy sw TD 3484 5" @ 3393

OVER

1952

6/11 CO to 3355 24/ 3336-42 4000 A  
S/ 400 bo 10 hr.  
Comp. 220 bopd 8% wtr.

**COMPLETED**

County **Barton** State **Kansas**

Sec. **28** (Blk. Twp.) **19** (Sur. Rge.) **12W** Map No.

Operator **B & R Drlg.**

Well No. **2** Farm **Johnson (B)**

Elev. Location **NE NE NW**

		0			

**330** Ft. From **N** Line **NW**

**330** Ft. From **E** Line **Quarter**

1st. Report **MAR 26 1952**

Completion

Remarks

**B & R Drlg. - Contr.**

Spudding Date **3-22-52**

Drlg. Data

**8" @ 148 Drlg. 650**

Scout Cards *mm*

Land Small Map

Land Wall Map *SR*

Tracings

France Map

Pierce Map

Misc.

MAR 28 1952

Orig. Data

County Barton State Kansas  
 Sec. 28 (Blk. 19) (Sur. 12W) (Twp.) (Rge.) Map No.  
 Operator B & R Drlg.  
 Well No. 2 Farm Johnson "B"  
 Elev. 1882 Location NE NE NW

		o			

330 Ft. From N Line NW330 Ft. From E Line Quarter

1st. Report

Completion JUN 11 1952

Remarks

B & R Drlg. - Contr.Spudding Date 3-22-52Drlg. Data Oil well TD 34848" @ 148 Anhy 715 Heeb. 3067Lans. 3200 DST 3252-82 open 1 hr.Rec. 30' mud DST 3327-42 open 1 1/2 hr.Rec. 280' hgco DST 3344-65 open 1 hr.Rec. 55' muddy sw TD 3484 5" @ 3393CO to 3355 24/ 3336-42 4000 AS/ 400 bo 10 hr.Comp. 220 bopd 8% water

J. G. McGEHEE

Scout Cards	.....
Land Small Map	.....
Land Vail Map	.....
Tracings	.....
France Map	.....
Pierce Map	.....
MISC.	.....

JUN 18 1952

Drig. Data