

KANSAS


Rice

FORM 51 5M PETROL

Section 28 Township 19 Range 10W

Well No. 2 Dittmer (Dittmers)

Company Sharon Drlg. ?

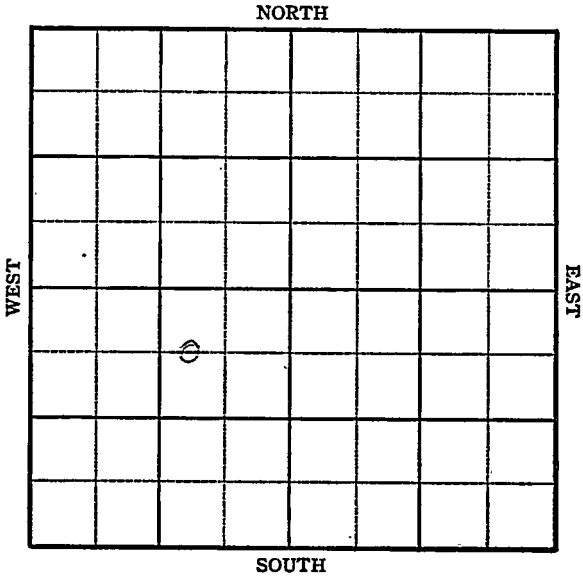

Sec. 28 Twp. 19 R. 10W

Well No. #2 Dittmer Farm

Sharon Drlg. Company


Silica

660 Ft. from N. Line

_____ Ft. from S. Line

990 Ft. from E. Line

_____ Ft. from W. Line

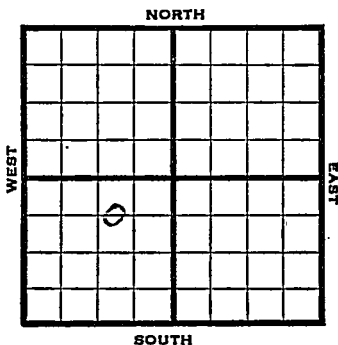

CWL NE SW

1945 **REPORT**
Elev. 1769

- 10/31 Location
- 11/74 10" @ 200
Drlg. 2300
- 11/14 Lans. 2959
Arb. 3294
TD 3294
5" @ 3294 RUST
- 11/21 Arb. 3299 corrected
5" @ 3298
TD 3304 SO
2000 acid.
- 11/28 TD 3306
Plug 3225
48 shots 3140-3151
24 shots 3046-3055
- 12/5 Arb. 3299
5" @ 3298
TD 3306'

ABANDONED

Kansas Pool Name Silica

KANSAS
 Map No. 46 Sec. 28 Twp. 19 R. 10W

Well No. 2 Dittmer

Sharon Drlg. Company

FIRST REPORT

Contractor

C W L NE SW

SECTION PLAT

660 Ft. from N. Line

_____ Ft. from S. Line

990 Ft. from E. Line

_____ Ft. from W. Line

	o		

Rice County

Location x

Rig up _____

Drilling and Remarks:

RECORD

Cased _____ in., _____ ft.

Sand _____

Gas _____

Oil _____

Total Depth _____

PRODUCTION

1st 24 hrs. Nat. _____

1st 24 hrs. after shot _____

Gas _____ Cu. Ft.

Dry Hole _____

Abandoned _____

Date

OCT 3 1 1945 19

S. J. LEWIS Scout

KANSAS

Kansas Pool Name Silica

Map No. K-46 Sec. 28 Twp. 19 R. 10W

Well No. 2 Dittmer

Sharon Drlg. Company

ABANDONED Contractor

C W L NE SW

E. 1769
SECTION PLAT

660 Ft. from N. Line

 Ft. from S. Line

990 Ft. from E. Line

 Ft. from W. Line

Rice County

Location _____

Rig up _____

Drilling and Remarks:

CR 8299

I-108299

RECORD

Cased _____ in., _____ ft.

Sand _____

Gas _____

Oil _____

Total Depth 2306

PRODUCTION

1st 24 hrs. Nat. _____

1st 24 hrs. after shot _____

Gas _____ Cu. Ft.

Dry Hole _____

Abandoned _____

Date

DEC 5 1945 19

S. J. LEWIS Scout