


Section 28 Township 19 Range 10-W

Well Number 5 - Dittmers

Company Skelly

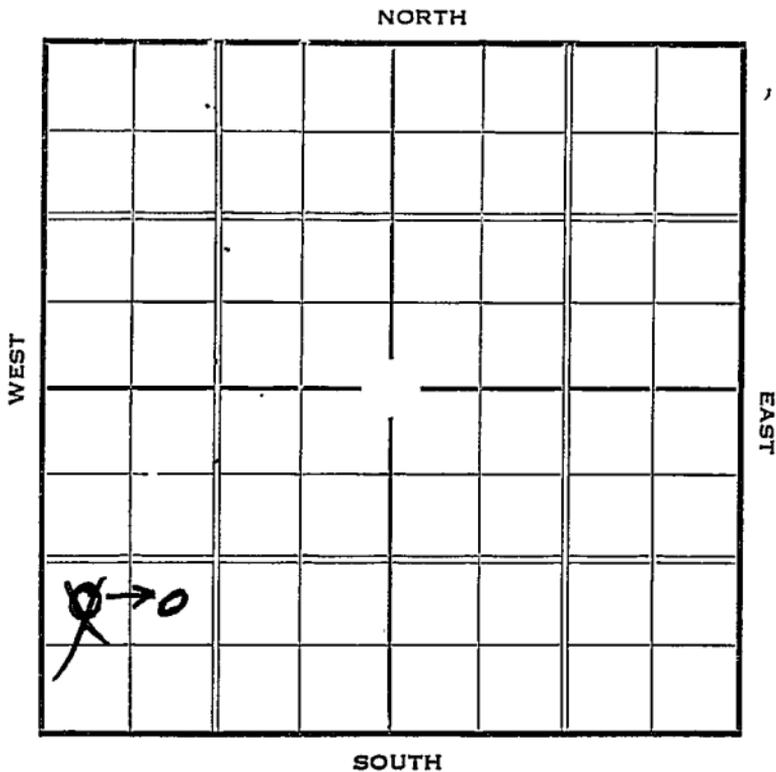

Sec. 28 Twp. 19 R. 10-W

Well No. #5 Dittmers Farm

Skelly Company


           Ft. from N. Line

990 Ft. from S. Line

           Ft. from E. Line

990  
~~390~~ Ft. from W. Line

Elev. 1778

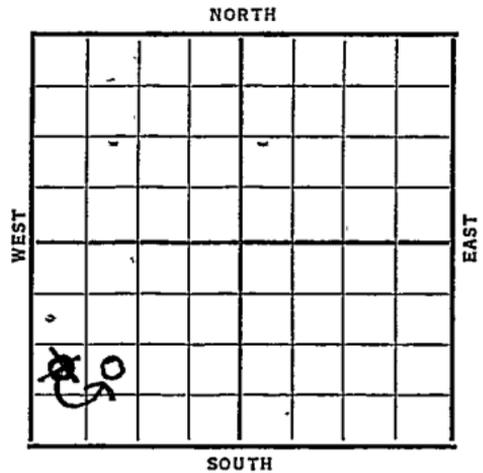

Date

REPORT

1937

5/19 B. R. R.

5/28 Rig

6/4 "

6/11 "

6/19 "

6/25 12" @ 190'. W00.

7/2 Drlg. 2125'.

7/9 Drlg. 3142'.

7/16 Sil. & 6" @ 3290'. Drlg. 3308  
250' oil in hole.

7/23 T.D. 3307'. 1500' oil in 18  
hrs. Cem. 5<sup>th</sup> liner 3300'.

7/30 1500 acid. Pumped 163 bbls.  
oil 6 hrs. 2000 acid.

OVER

1937

8/4 7" @ 3290'.

Sil. 3290'.

T.D. 3307'.

4500 acid.

Pot. 983 bbls.

COMPLETED

Rice KANSAS

Map No. 46 Sec. 28 Twp. 19 R. 10 WWell No. 5-DittmersSkelly Company

Contractor

## FIRST REPORT

## SECTION PLAT

1 Ft. from N. Line990 Ft. from S. Line

\_\_\_\_\_ Ft. from E. Line

390 Ft. from W. Line

•			
o			

Location \_\_\_\_\_

Rig up \_\_\_\_\_

Drilling and Remarks:

B.R.R.

## RECORD

Cased \_\_\_\_\_ in., \_\_\_\_\_ ft.

Sand \_\_\_\_\_

Gas \_\_\_\_\_

Oil \_\_\_\_\_

Total Depth \_\_\_\_\_

## PRODUCTION

1st 24 hrs. Nat. \_\_\_\_\_

1st 24 hrs. after shot \_\_\_\_\_

Gas \_\_\_\_\_ Cu. Ft.

Dry Hole \_\_\_\_\_

Abandoned \_\_\_\_\_

Date

MAY 19 1937  
19H. D. Hatfield  
Scout

*Paul*  
*Ray*

Returned	
Cards	<i>Paul</i>
Tracing	<i>JP</i>
France Map	<i>✓</i>
Scarborough Map	<i>✓</i>
Moody Map	<i>✓</i>
Scarborough Plat Book	
Moody Plat Book	

Map No. 46 Sec. 28 Twp. 19 R. 10<sup>w</sup>Well No. 5 DittmersSkelly Company

Contractor

## CORRECTION

\_\_\_\_\_ Ft. from N. Line

990 Ft. from S. Line

\_\_\_\_\_ Ft. from E. Line

990 Ft. from W. Line

## SECTION PLAT

0 → 0			

Location \_\_\_\_\_

Rig up \_\_\_\_\_

Drilling and Remarks:

Loc. changed fromNWswsw

## RECORD

Cased \_\_\_\_\_ in., \_\_\_\_\_ ft.

Sand \_\_\_\_\_

Gas \_\_\_\_\_

Oil \_\_\_\_\_

Total Depth \_\_\_\_\_

## PRODUCTION

1st 24 hrs. Nat. \_\_\_\_\_

1st 24 hrs. after shot \_\_\_\_\_

Gas \_\_\_\_\_ Cu. Ft.

Dry Hole \_\_\_\_\_

Abandoned \_\_\_\_\_

Date

JUN 23 1937 19H. D. Hatfield Scout

RAY

Returned	
Cards	<i>[Signature]</i>
Tracing	<i>[Signature]</i>
France Map	<i>[Signature]</i>
Scarborough Map	<i>[Signature]</i>
Moody Map	<i>[Signature]</i>
Scarborough Plat Book	
Moody Plat Book	

Rice KANSASMap No. \_\_\_\_\_ Sec. 28 Twp. 19 R. 10<sup>w</sup>Well No. 5 - DittmersSpelly \_\_\_\_\_ Company

\_\_\_\_\_ Contractor

## COMPLETED

## SECTION PLAT

\_\_\_\_\_ Ft. from N. Line

990 Ft. from S. Line

\_\_\_\_\_ Ft. from E. Line

990 Ft. from W. Line

0			

Location \_\_\_\_\_

Rig up \_\_\_\_\_

Drilling and Remarks:

4500 acidPat - 983

## RECORD

Cased 7 in., 3290 ft.Sand 511 3290

Gas \_\_\_\_\_

Oil \_\_\_\_\_

Total Depth 3307

## PRODUCTION

1st 24 hrs. Nat. \_\_\_\_\_

1st 24 hrs. after shot \_\_\_\_\_

Gas \_\_\_\_\_ Cu. Ft.

Dry Hole \_\_\_\_\_

Abandoned \_\_\_\_\_

Date

AUG 4 - 1937H. D. Hatfield Scout

*Gene.*

Returned	
Cards	<i>Paul</i>
Tracing	<i>Gene</i>
France Map	<i>Gene</i>
Scarborough Map	<i>Gene</i>
Moody Map	<i>Gene</i>
Scarborough Plat Book	
Moody Plat Book	