


Section 28 Township 19 Range 10-W

Well Number 2 Dittmers

Company Skelly Oil Co.

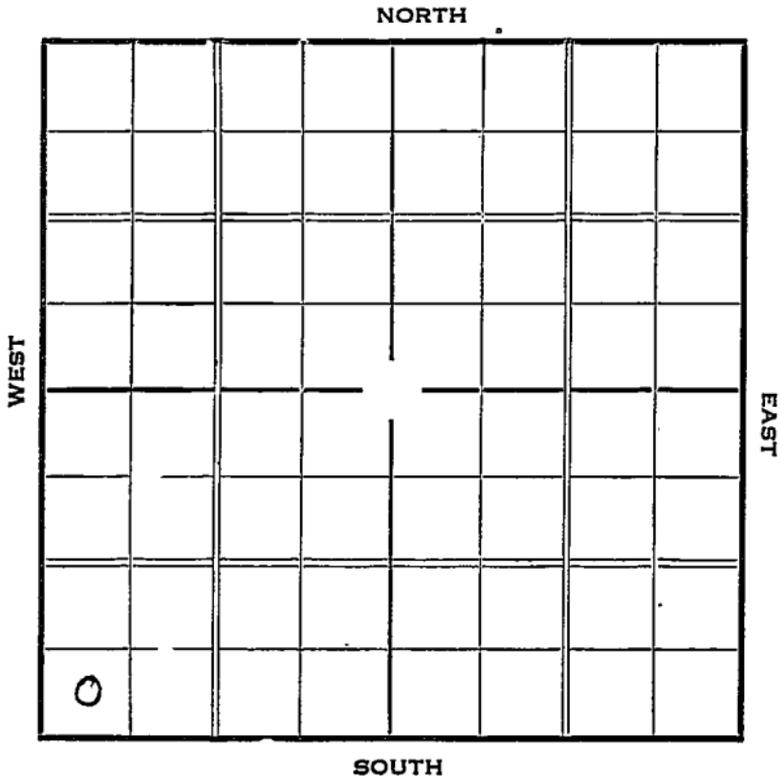

Sec. 28 Twp. 19 R. 10-W

Well No. #2 Dittmers Farm

Skelly Oil Co. Company

Chase-Silica Pool

NORTH

 Ft. from N. Line


330 Ft. from S. Line

 Ft. from E. Line

330 Ft. from W. Line

Sw Sw Sw

Elev. 1779

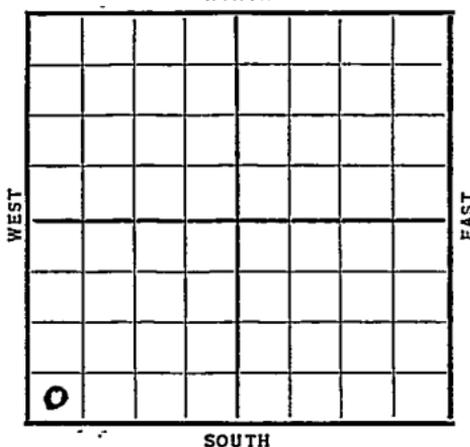

Date	REPORT
------	--------

1937	
2/17	R O G
2/26	Rigging up.
3/4	Drlg. 1300'.
3/11	Drlg. 2975'.
3/18	Sil 3265' Set 7" WOC
3/25	T.D. 3275'. 2000 acid.
	Pump 1686.
3/31	Sil. 3265'.
	T. D. 3275'.
	4500 acid.
	Potential 2334.
	COMPLETED

1955	O. W. P. B.
8/10	Old Info: 7" @ 3264' OTD 3275' Pot. 2334 BOPD.
	NEW INFORMATION: PB 3240; 72/3198-3210 Swb 12 BWPB 6 hrs; PB 3180'; 49/3156- 64; 2500 A; Swb 18 BO + 35 BW 17 hrs 25/3113-17; 500 A; Swb 2 GO + 7 BWPB; 43/3063-73; 2500 A; Swb 20 BO + 50 BW 15 hrs. 50/3026-35; 500 A; Swb 2 GW 1 hr; PB 3008; 23/2760-65; 1300 A Swb 17 BW 16 hrs. 63/2697-2714;

OVER

1955
8/10

(Information continued)

OWPB: 500 A Swab 25 BW 13 hrs.

Sqz perfs 2697-2765; CO 3180'

Pump 27 B0 + 35 BWPD

L. 2977', A. 3260'

PBTD 3240'

FIRST REPORT

↓
COMPLETED

KANSAS

Map No. 46 Sec. 28 Twp. 19 R. 10W

Well No. 2 Pittman

Skelly Company
Contractor

SECTION PLAT

_____ Ft. from N. Line

330 Ft. from S. Line

_____ Ft. from E. Line

330 Ft. from W. Line

FIRST REPORT

Location _____

Rig up _____

Drilling and Remarks:

R.O.G.

RECORD

Cased _____ in., _____ ft.

Sand _____

Gas _____

Oil _____

Total Depth _____

PRODUCTION

1st 24 hrs. Nat. _____

1st 24 hrs. after shot _____

Gas _____ Cu. Ft.

Dry Hole _____

Abandoned _____

Date

FEB 17 1937 19

S. J. LEWIS Scout

Paul

Paul

Returned	_____
Cards	<i>Paul</i>
Tracing	<i>gpr</i>
France Map	<i>Paul</i>
Scarborough's Map	<i>Paul</i>
Moody Map	_____
Scarborough Plat Book	_____
Moody Plat Book	_____

KANSAS *Rice*

Map No. _____ Sec. 28 Twp. 19 R. 10W

Well No. 2 Pittman

Skelly Company
 _____ Contractor

SECTION PLAT

0			

_____ Ft. from N. Line

330 Ft. from S. Line

_____ Ft. from E. Line

330 Ft. from W. Line

COMPLETED

Location _____

Rig up _____

Drilling and Remarks:

Sil 3265
4500 acid
Potential
2384

RECORD

Cased _____ in., _____ ft.

Sand _____

Gas _____

Oil _____

Total Depth 3275

PRODUCTION

1st 24 hrs. Nat. _____

1st 24 hrs. after shot _____

Gas _____ Cu. Ft.

Dry Hole _____

Abandoned _____

Date

MAR 31 1937

19

S. J. LEWIS Scout

Paul
Ray

Returned	<i>Paul</i>
Cards	<i>Paul</i>
Tracing	<i>Ray</i>
France Map	<i>Ray</i>
Scarborough Map	<i>Ray</i>
Moody Map	<i>Ray</i>
Scarborough Plat Book	
Moody Plat Book	

O. W. P. B.

FORM 513 REV. SUNRAY

County Rice Elev. 1779 DF
 Sec. 28 Twp. 19S Rge. 10W
 Company Skelly Oil Co.
 Farm Name D. P. Bittmers No. 2

No. 2
OWPB
 Loc. in Sec.

TOPS	DEPTH	LOG	DATUM
Anh.			
Tp.			
H.			
Tr.			
Dg.			
Bl.			
L.	2977		
K.C.			
B.K.C.			
Ce.			
C.			
M.			
M.			
K.			
Mz.			
Ma.			
V.			
S.			
S.			
A.	3260		
R.			
PE.			
G.			
T.D.			

SW SW SW
 Geol. _____
 Contr. _____
 Pool Chase
 S 17 ca

FIRST REPORT
 AUG 10 1955
COMPLETE

Date Comm. Old info - 7" 3261; TD 3275; P.t. 2334
bond

New info - PB 3240; 72/6198-3210; swb 12 bwph
6 hrs.; PB 3180; 49/3156-64; 2500 A; swb 18
bo / 35 bw 17 hrs.; 25/3113-17; 500 A;
swb 2 go / 7 bwph; 43/3063-73; 2500 A;
swb 20 bo / 50 bw 15 hrs.; 50/3026-35; 500 A;
swb 2 gw 1 hr.; PB 3008; 23/2760-65; 1300 A;
swb 17 bw 16 hrs.; 63/2697-2714; 500 A;

OVER

Scout Cards
Land Small Map
Land Wall Map
Tracings
France Map
Pierce Map
Misc.

AUG 16 1955

SWB 25 PW 13 hrs.; sq parts 2697-2865;
 GO 3180; pmp 27 bo 7 35 bmpd