

Section 28 Township 19 Range 10 W

Well No. # 3 Gossman

Company J. Bergman

NORTH

	0						

WEST

EAST

SOUTH

Rice

KANSAS

Sec. 28 Twp. 19 R. 10 W

Well No. # 3 Gossman Farm

J. Bergman Company

Contractor

Silicia Pool


330 Ft. from N. Line

_____ Ft. from S. Line

_____ Ft. from E. Line

990 Ft. from W. Line

NE NW NW

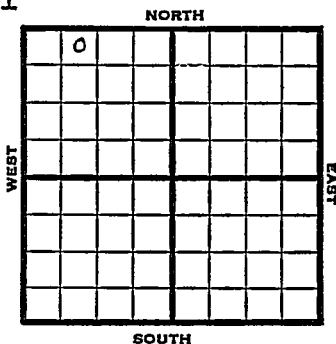

1951 Elev. 1768' REPORT

6/20 Spud 6-18-51

7/3 Spud 6-18-51 D & A TD 3318'
 8" @ 156' Anhy 455' Top 2848'
 Heeb 2943' Br. lime 2968' KC 3000'
 Arb. 3315'
 DST 3315-18 open 1/2 hr. rec 5' mud
 D & A

ABANDONED

County Pice State Kansas

Sec. 28 (Blk.) 19 (Sur.) 10W Map No.

Operator J. Bergman

Well No. 3 Farm Gossman

Elev. 338 Location: NE NW NW

0					
X					
FIRST REPORT					

~~338~~ Ft. From N Line NW

990 Ft. From W Line Quarter

Ist. Report JUN 20 1951

Completion _____

Remarks _____

Spudding Date 6-18-51

Drlg. Data Silicia Pool

County Rice State Kansas

Sec. 28 (Blk. Twp.) 19 (Sur. Rge.) 10W Map No.

Operator J. Bergman

Well No: 3 Farm Gossman

Elev. 1768 Location NE NW NW

o					

³³⁰
990 Ft. From N Line NW
990 Ft. From W Line Quarter

Ist. Report

Completion JUL 3 1951

Remarks Silica Pool

Spudding Date 6-18-51

Drig. Data D & A TD 3318

8" @ 156 Anhy 455 Top. 2848

Heeb. 2943 Br. lime 2968 KC 3000

Arb. 3315 DST 3315-18 open $\frac{1}{2}$ hr.

Rec. 5' mud D & A