

Rice


KANSAS

FORM 51 5M 2-38 TPCO.

Section 28 Township 19 Range 10-W

Well No. 1 Ed Gossman

Company Stanolind

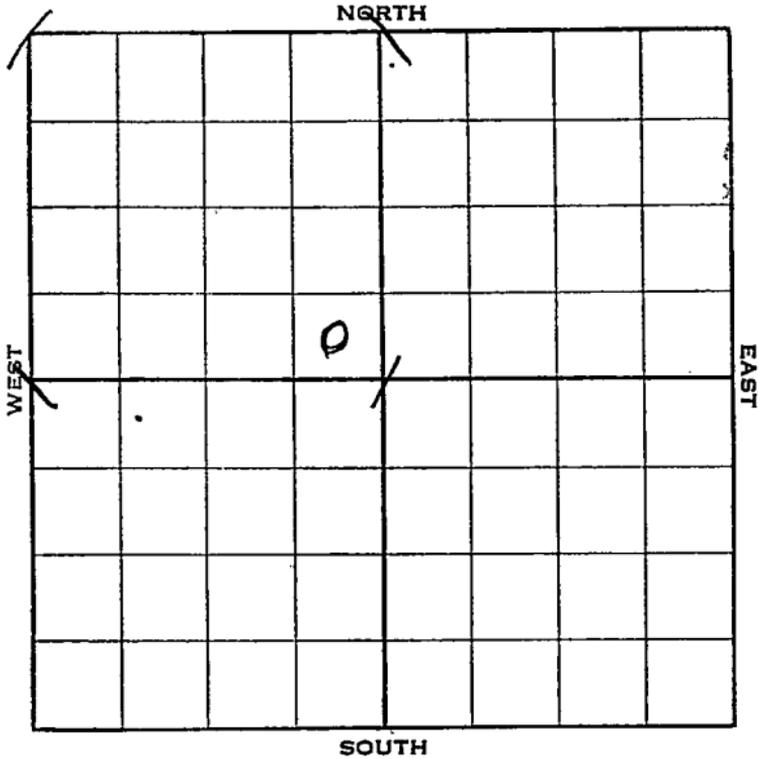

Sec. 28 Twp. 19 R. 10-W

Well No. #1 Ed. Gossman Farm
Stanolind Company


_____ Ft. from N. Line

330 Ft. from S. Line

330 Ft. from E. Line

_____ Ft. from W. Line

Elev. 1763

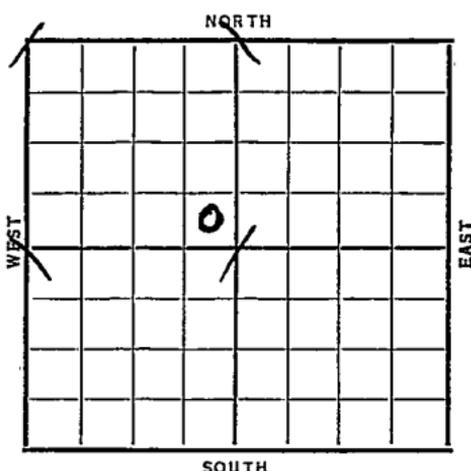

Date	REPORT
1938	
3/9	Location
3/18	R U R
3/25	10" @ 230'. Drlg. 1377'.
4/1	Drlg. 2853'.
4/8	Lans. 2977'. S.O. 3056-68'.
	Arb. 3288-94' T.D. Sat. core.
	6" @ 3288'. RUST.
4/15	T.D. 3301'. 12 gal. oil per hr.
	May shoot.
4/22	Shot 20 qts. 4000 acid.
4/29	Pump 125 oil & 60 wtr. 24 hrs.
	Pump 87 oil & 132 wtr. 24 hrs.
	Pump 67 oil & 122 wtr. in 24 hrs

OVER

1938

5/4

6" @ 3288'.

Arb. 3288'.

T.D. 3301'.

Shot 20 qts.

4000 acid.

Potential 125 oil & .60 water.

COMPLETED

Rice

KANSAS

Map No. 46 Sec. 28 Twp. 19 R. 10W

Well No. 1 Ed Gossman

Stanford Company

Contractor

FIRST REPORT

SE NW


_____ Ft. from N. Line

330 Ft. from S. Line

330 Ft. from E. Line

_____ Ft. from W. Line

SECTION PLAT

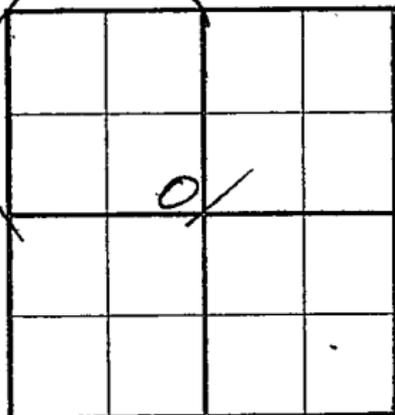

Location X

Rig up _____

Drilling and Remarks:

RECORD

Cased _____ in., _____ ft.

Sand _____

Gas _____

Oil _____

Total Depth _____

PRODUCTION

1st 24 hrs. Nat. _____

1st 24 hrs. after shot _____

Gas _____ Cu. Ft.

Dry Hole _____

Abandoned _____


Date

MAR 9 - 1938 19


H. D. Hatfield

Scout

2
RAY

 

Returned	
Cards	Paul
Tracing	Joe
France Map	Ray
Scarborough Map	Ray
Moody Map	
Scarborough Plat Book	
Moody Plat Book	

 

Returned	
Cards	<i>Paul</i>
Tracing	<i>Jim</i>
France Map	<i>RBY</i>
Scarborough Map	<i>RBY</i>
Moody Map	<i>RBY</i>
Scarborough Plat Book	
Moody Plat Book	