


Section 28 Township 19 Range 10-W

Well No. 1 - L. F. Manke

Company Stanolind

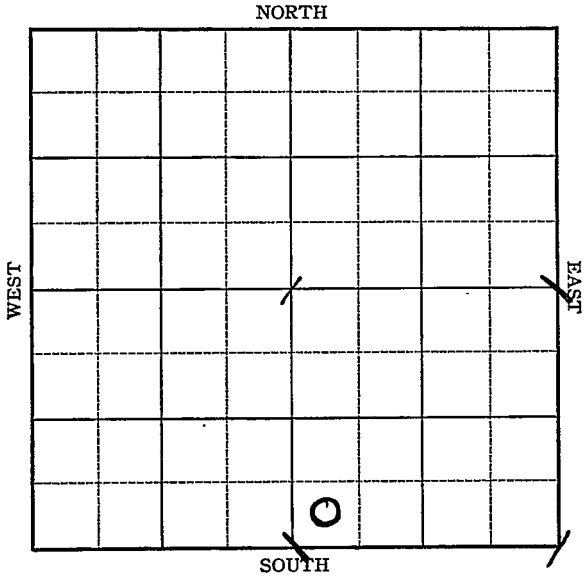

Sec. 28 Twp. 19 R. 10-W

Well No. #1 L. F. Manke Farm

Stanolind Company


_____ Ft. from N. Line

330 Ft. from S. Line

_____ Ft. from E. Line

330 Ft. from W. Line

Elev. 1778

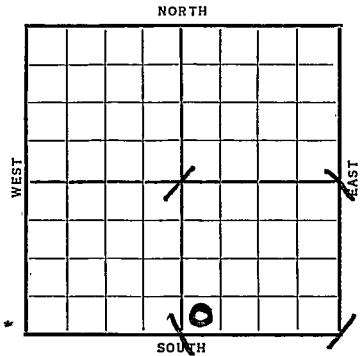

Date	REPORT
1937	
6/9	Mov. in Rot.
6/19	R U R
6/25	10" @ 202'. Drlg. 1485'.
7/2	Drlg. 2945'.
7/9	Sil. 3257'. 7" @ 3257'. T.D. 3272'.
7/12	T.D. 3272'. 2000' oil & water in 3 hrs. P.B.
7/23	P.B. 3268'. Swab 5 bbls. oil & 2½ B.W. P.H. P.B. 3265'.
7/30	Drlg. out lead plug @ 3270'.
8/6	P.B. 3267'.
8/13	Shot 10 qts. 3258-65'. C.O.
8/20	T.D. 3267'. 100 acid. 600' oil & 2000' water. Plugging back.
8/28	P.B. 3262'.
9/3	P.B. 3261'. WOC.
	OVER

Rice KANSAS

Map No. 46 Sec. 28 Twp. 19 R 10 WWell No. 1 - L. F. MankeStanford Company

Contractor

FIRST REPORT

SECTION PLAT

_____ Ft. from N. Line

330 Ft. from S. Line

_____ Ft. from E. Line

330 Ft. from W. Line

Location _____

Rig up _____

Drilling and Remarks:

Mo. in Rat,

RECORD

Cased _____ in., _____ ft.

Sand _____

Gas _____

Oil _____

Total Depth _____

PRODUCTION

1st 24 hrs. Nat. _____

1st 24 hrs. after shot _____

Gas _____ Cu. Ft.

Dry Hole _____

Abandoned _____

Date

JUN 9 1937

19

H. D. Hatfield

Scout

Map No. _____ Sec. 28 Twp. 19 R. 10W

Well No. 1-J. F. Manke

Stanolind Company

Contractor _____

ABANDONED

SECTION PLAT

_____ Ft. from N. Line

330 Ft. from S. Line

_____ Ft. from E. Line

330 Ft. from W. Line

		0	

Location _____

Rig up _____

Drilling and Remarks:

P. B. 3267
shot 10 gts.
1000 acid
P. B 3261

D + A

RECORD

Cased 7 in. 3257 ft.
Sand 3257

Gas _____

Oil _____

Total Depth 3272

PRODUCTION

1st 24 hrs. Nat. _____

1st. 24 hrs. after shot _____

Gas _____ Cu. Ft.

Dry Hole _____

Abandoned _____

Date

SEP 8 1937

H. D. Hatfield