

Rice

KANSAS


Form 51-5M-11-38-Palace

Section 28 Township 19 Range 10-W

Well No. #3 L. F. Manke

Company Stanolind

NORTH **Silica Pool**

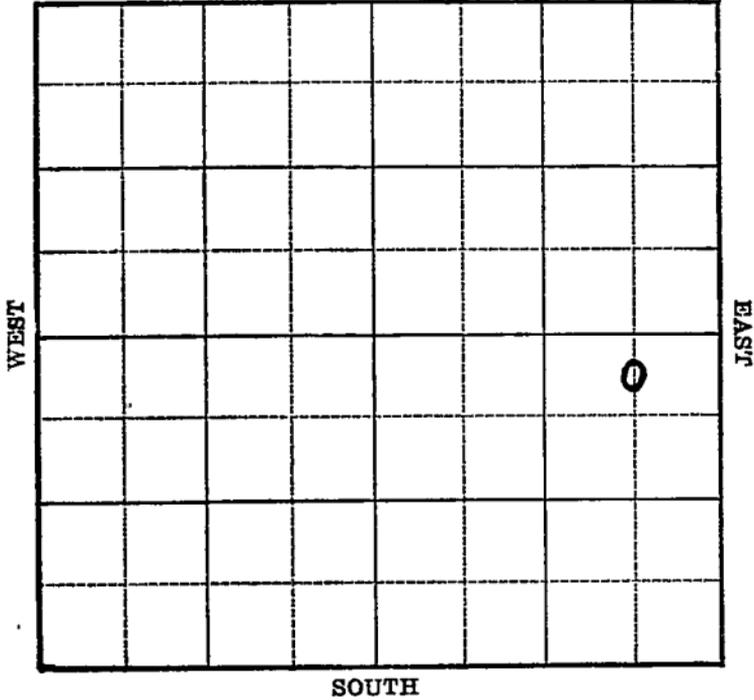

Sec. 28 Twp. 19 R. 10-W

Well No. #3 L. F. Mahke Farm

Stanolind

Company

(Silica)


330 Ft. from N. Line

_____ Ft. from S. Line

660 Ft. from E. Line

_____ Ft. from W. Line

Elev. 1759

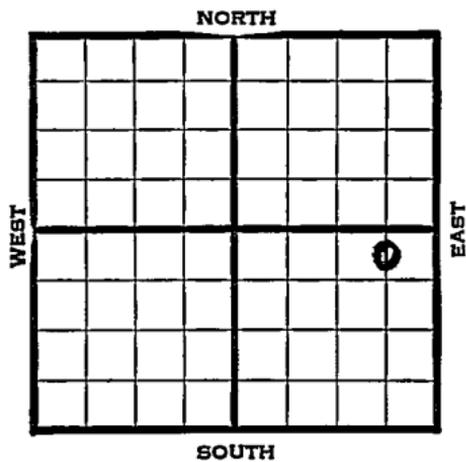

1939	REPORT
7/12	Location
7/20	10" - 219' WOC.
7/27	DrLg. 2635'
8/3	Lans. 2956' 7" - 3028'
	T.D. 3039½' Swab 11 bbl sl. per
	hour 2 hrs.
8/9	Lans. 2956'
	7" - 3028'
	T.D. 3039½'
	3000 acid.
	Potential 1968 bbls., pump.
	COMPLETED

Rice

KANSAS

Map No. 46 Sec. 28 Twp. 19 R. 10WWell No. 3 L. F. MankeStanolind

Company

Contractor

FIRST REFOOT

SECTION PLAT

C $N\frac{1}{2}$ NE SE330 Ft. from N. Line Ft. from S. Line660 Ft. from E. Line Ft. from W. Line

			0

SILICA POOL

Location XRig up

Drilling and Remarks:

RECORD

Cased in., ft.Sand Gas Oil Total Depth

PRODUCTION

1st 24 hrs. Nat. 1st 24 hrs. after shot Gas Cu. Ft.Dry Hole Abandoned

Date

JUL 12 1935 19

S. J. LEWIS

Scout

Rice

KANSAS

Map No. 46 Sec. 28 Twp. 19 R. 10W

Well No. 3 L. F. Manke

Stanolind

Company

Contractor

COMPLETED

C $N\frac{1}{2}$ NE SE

330 Ft. from N. Line

_____ Ft. from S. Line

660 Ft. from E. Line

_____ Ft. from W. Line

SECTION PLAT

			0

SILICA POOL

Location _____

Rig up _____

Drilling and Remarks:

Loss 2956
7" @ 3028.
3000 acid
Pump 1968/88

RECORD

Cased _____ in., _____ ft.

Sand _____

Gas _____

Oil _____

Total Depth 3039 1/2

PRODUCTION

1st 24 hrs. Nat. _____

1st 24 hrs. after shot _____

Gas _____ Cu. Ft.

Dry Hole _____

Abandoned _____

Date

AUG 9 1939

19

Scout