


Section 28 Township 19 Range 10-W


Well No. #4 Manke

Company Stanolind

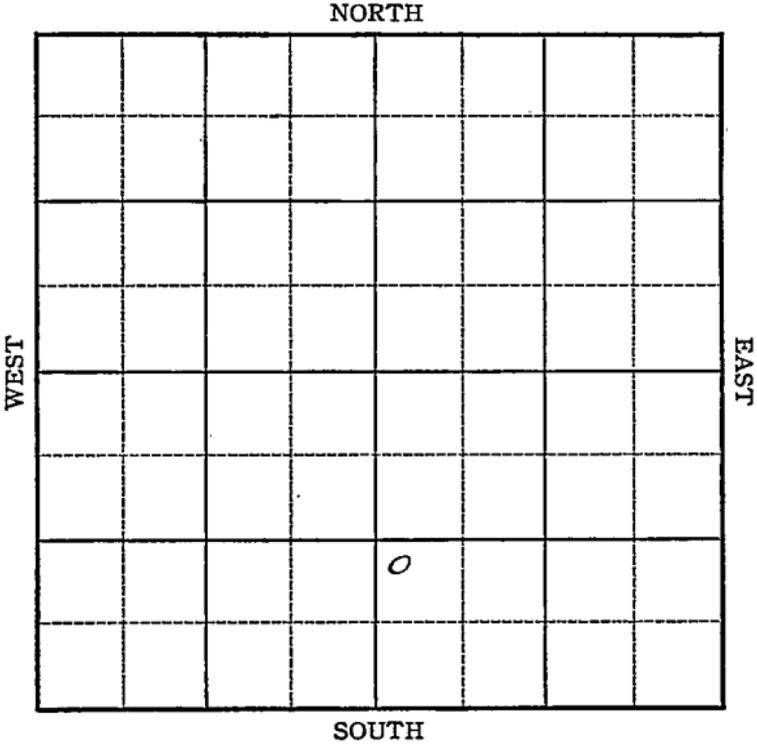

Sec. 28 Twp. 19 R. 10-WWell No. #4 Manke FarmStanolind Company Ft. from N. Line990 Ft. from S. Line Ft. from E. Line330 Ft. from W. Line

Elev. 1770

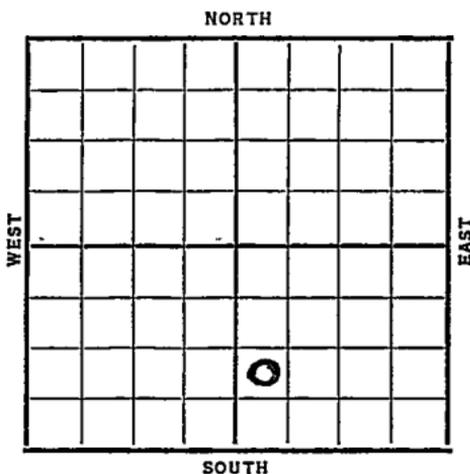

Date	REPORT
1937	
9/15	R.R.
10/2	10" @ 206'. Anhy 425'.
	Drlg. 2450'.
10/8	Sil. 3243-45' S.O.
	6" @ 3243'. RUST.
10/15	T.D. 3252'. $\frac{1}{2}$ B.O.P.H.
10/22	T.D. 3252'. 300 acid.
	No help. 20 qts. No help.
	300 acid. Drlg. 3253'.
	400' oil.
10/29	T.D. 3254'. Swab 4 bbls. oil
	per hour off bottom.
	1000 acid.
11/5	T.D. 3262'. 1500 acid.
	Swab 1 bbl. oil. P. H.
11/12	T.D. 3265'. 500 acid.
	Shot 20 qts. 1200' oil.
	500 acid.
11/19	5000 acid. On potential.
	OVER

1937

11/23 6" @ 3243'.

Sil. 3243'.

T.D. 3265'.

9100 acid-total.

Shot 40 qts.

Potential 315 bbls.

COMPLETED

Rice KANSAS

Map No. _____ Sec. 28 Twp. 19 R. 10 ^W

Well No. 4 - Manke

Stanolind Company

Contractor _____

FIRST REPORT

_____ Ft. from N. Line

990 Ft. from S. Line

_____ Ft. from E. Line

330 Ft. from W. Line

SECTION PLAT

		0	

Location _____

Rig up _____

Drilling and Remarks:

RR.

RECORD

Cased _____ in., _____ ft.

Sand _____

Gas _____

Oil _____

Total Depth _____

PRODUCTION

1st 24 hrs. Nat. _____

1st 24 hrs. after shot _____

Gas _____ Cu. Ft.

Dry Hole _____

Abandoned _____

Date

SEP 15 1937 19

H. D. Hatfield


Scout

Sam - Our tracing shows only 2 wells
in this 1/4 Sec. Please have scout
check well # on this loc.

Pittman

Number OK.
N.A.H.

RAY

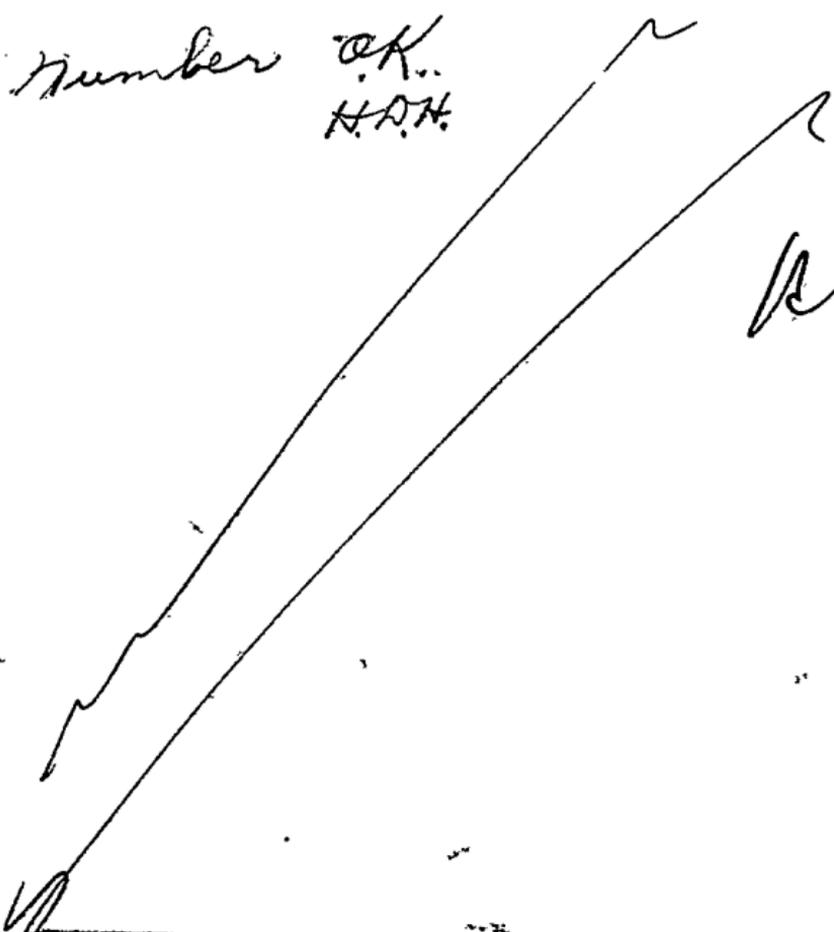

Returned	
Cards	John Ray
Tracing	John Ray
France Map	John Ray
Scarborough Map	John Ray
Moody Map	John Ray
Scarborough Plat Book	
Moody Plat Book	

Rice

KANSAS

Map No. 46 Sec. 28 Twp. 19 R. 10WWell No. 4 MankeStanolind

Company

Contractor

COMPLETED

NW SW SE

 Ft. from N. Line990 Ft. from S. Line Ft. from E. Line330 Ft. from W. Line

SECTION PLAT

		●	

Location Rig up

Drilling and Remarks:

900 Acid - Total
Shot 40 gts ✓

POT - 315

RECORD


Cased 6 in., 3243 ft.~~Sand~~ 511 3243Gas Oil Total Depth 3265

PRODUCTION

1st 24 hrs. Nat. 1st 24 hrs. after shot Gas Cu. Ft.Dry Hole Abandoned

Date

NOV 23 1937 19H. D. Hatfield Scout

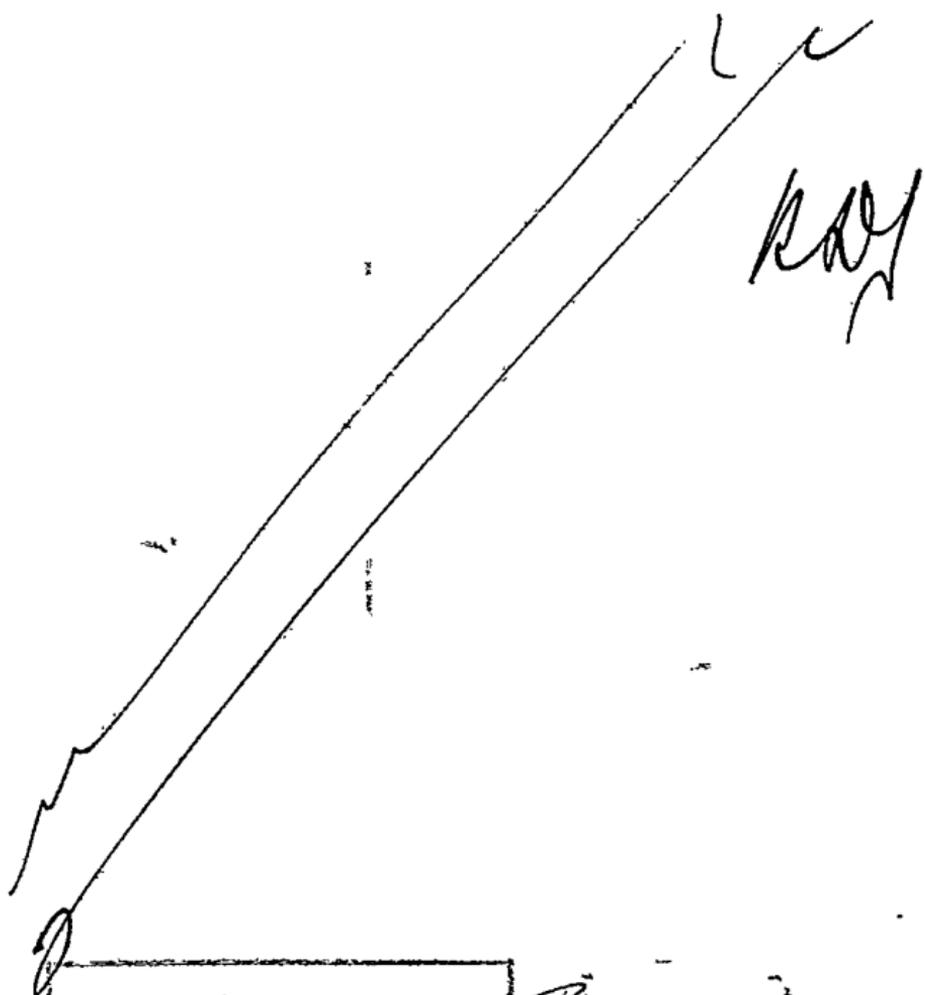

Returned	
Moody Flat Book	